


\\us5\BMS\520\02837.dgn

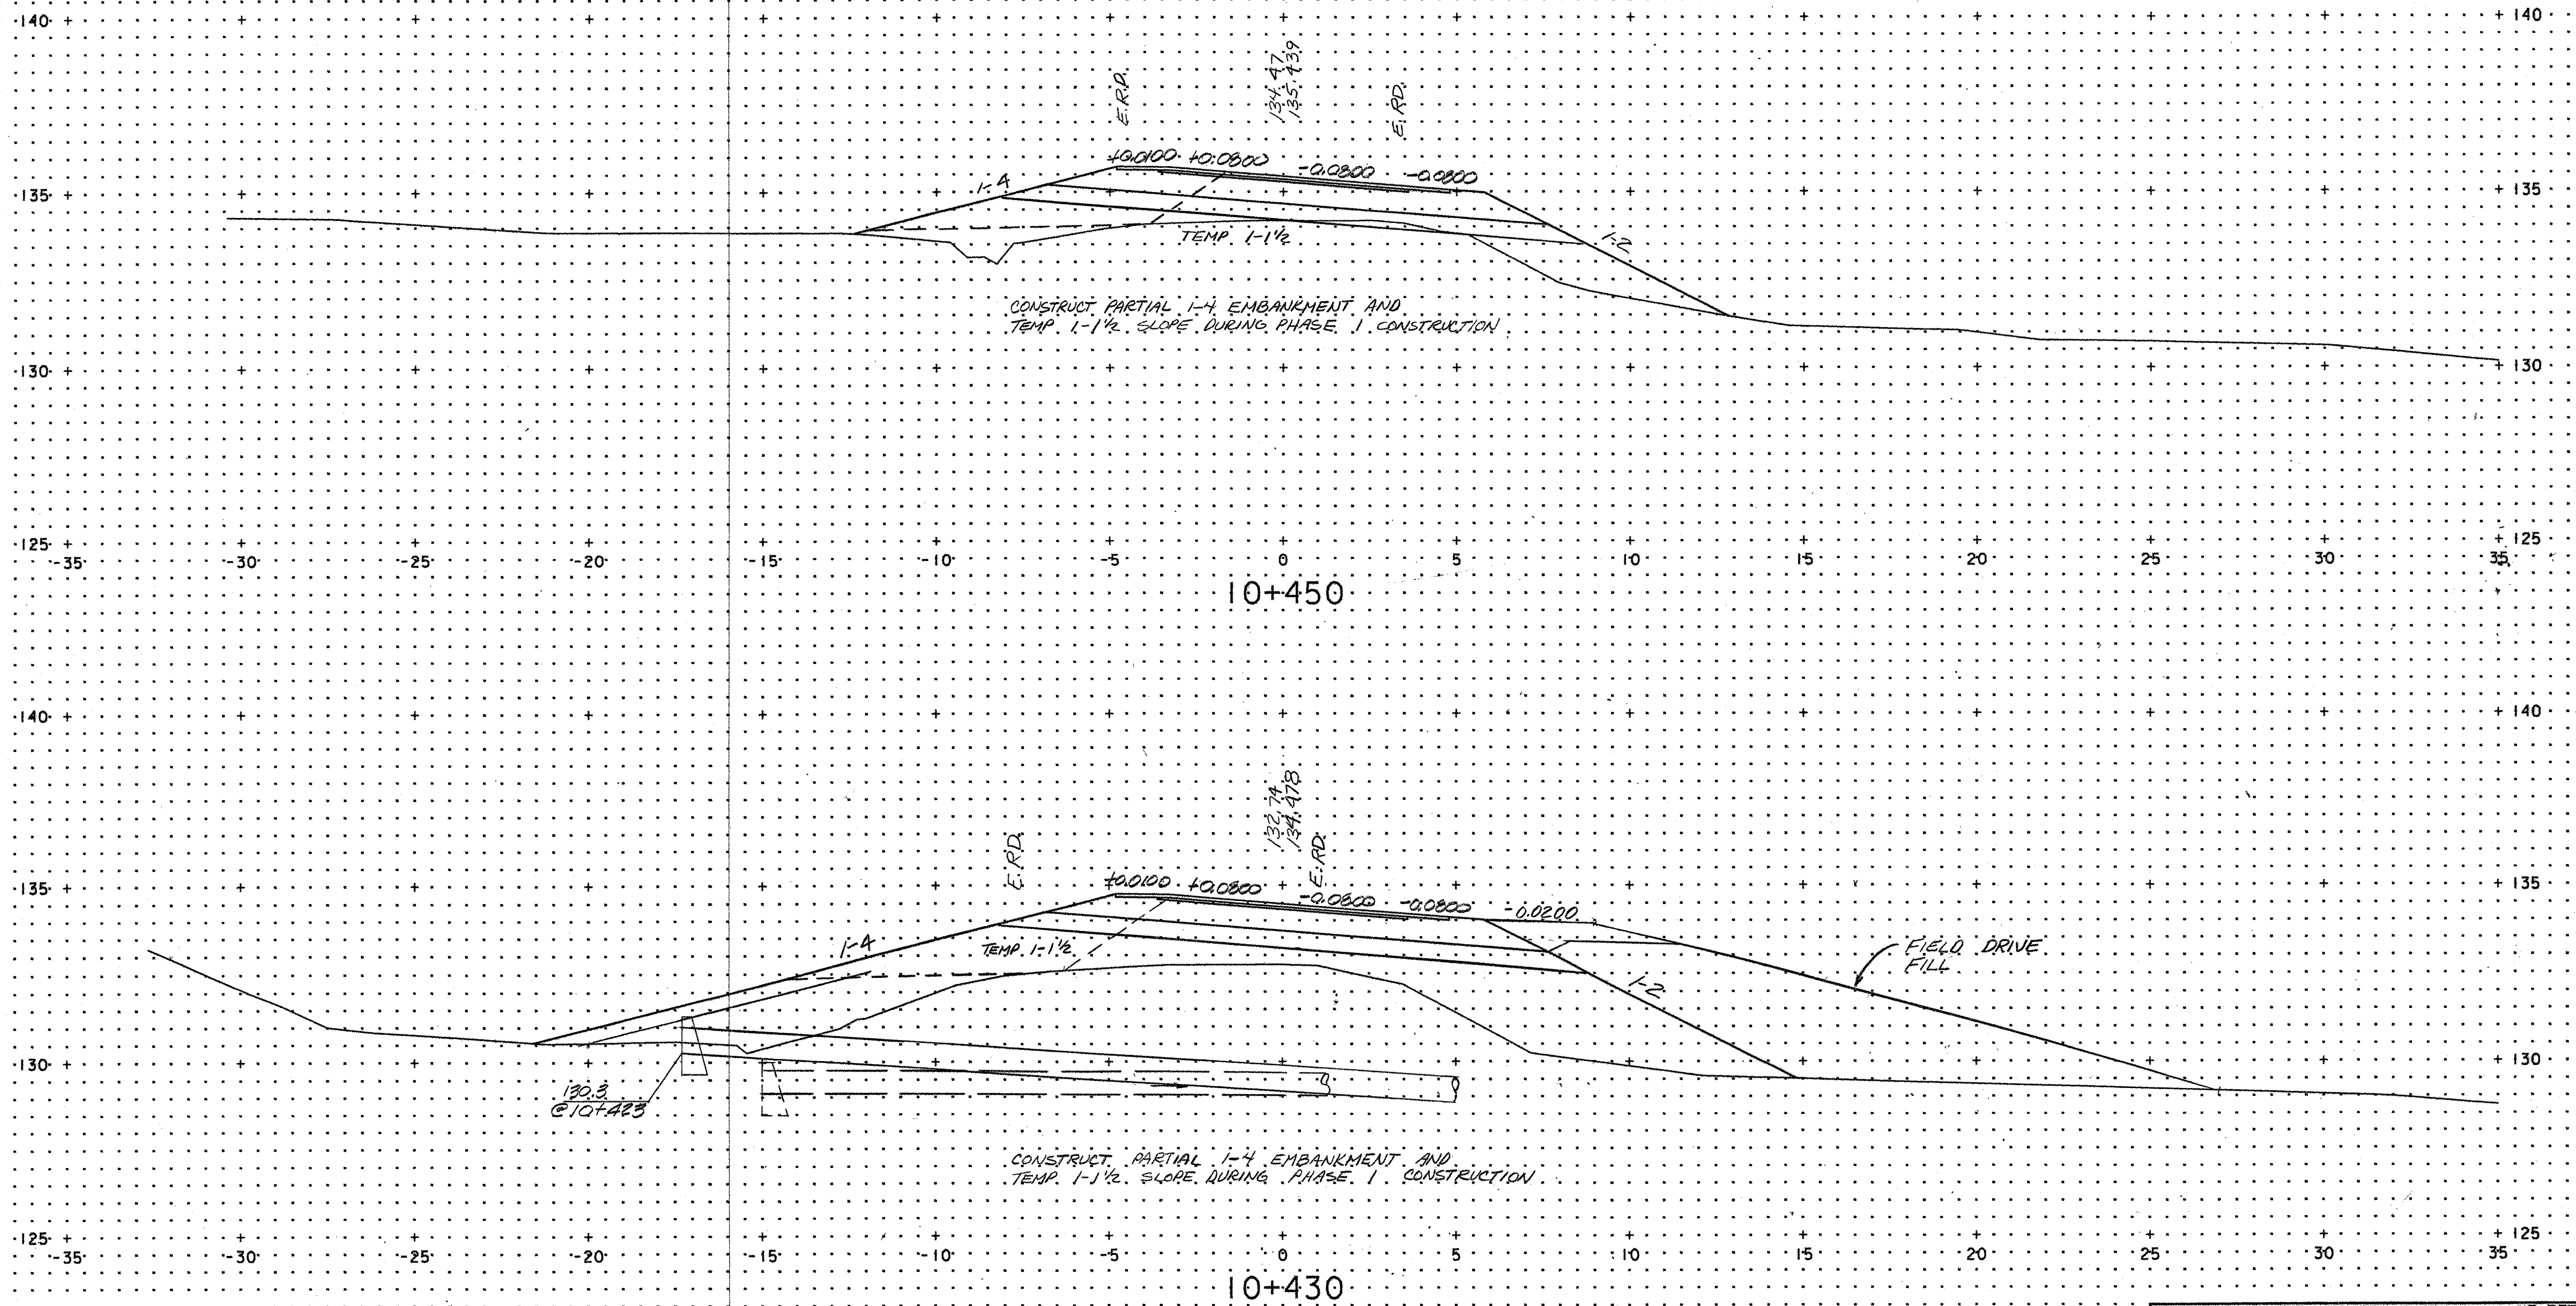

SCALE 1" = 10'

FROM STA. 10+430 TO STA. 10+450 VT. RTE. 118
PROJECT NAME: VERMONT ROUTE 118 OVER TROUT RIVER
PROJECT NO. BRS 0283(7)
PLOTTED BY: CJM 10/28/96 CHECKED BY: JAV 10/29/96
SHEET 75 OF 140 SHEETS

784184/24184X08