


7/28/96/1845620/02837.dgn

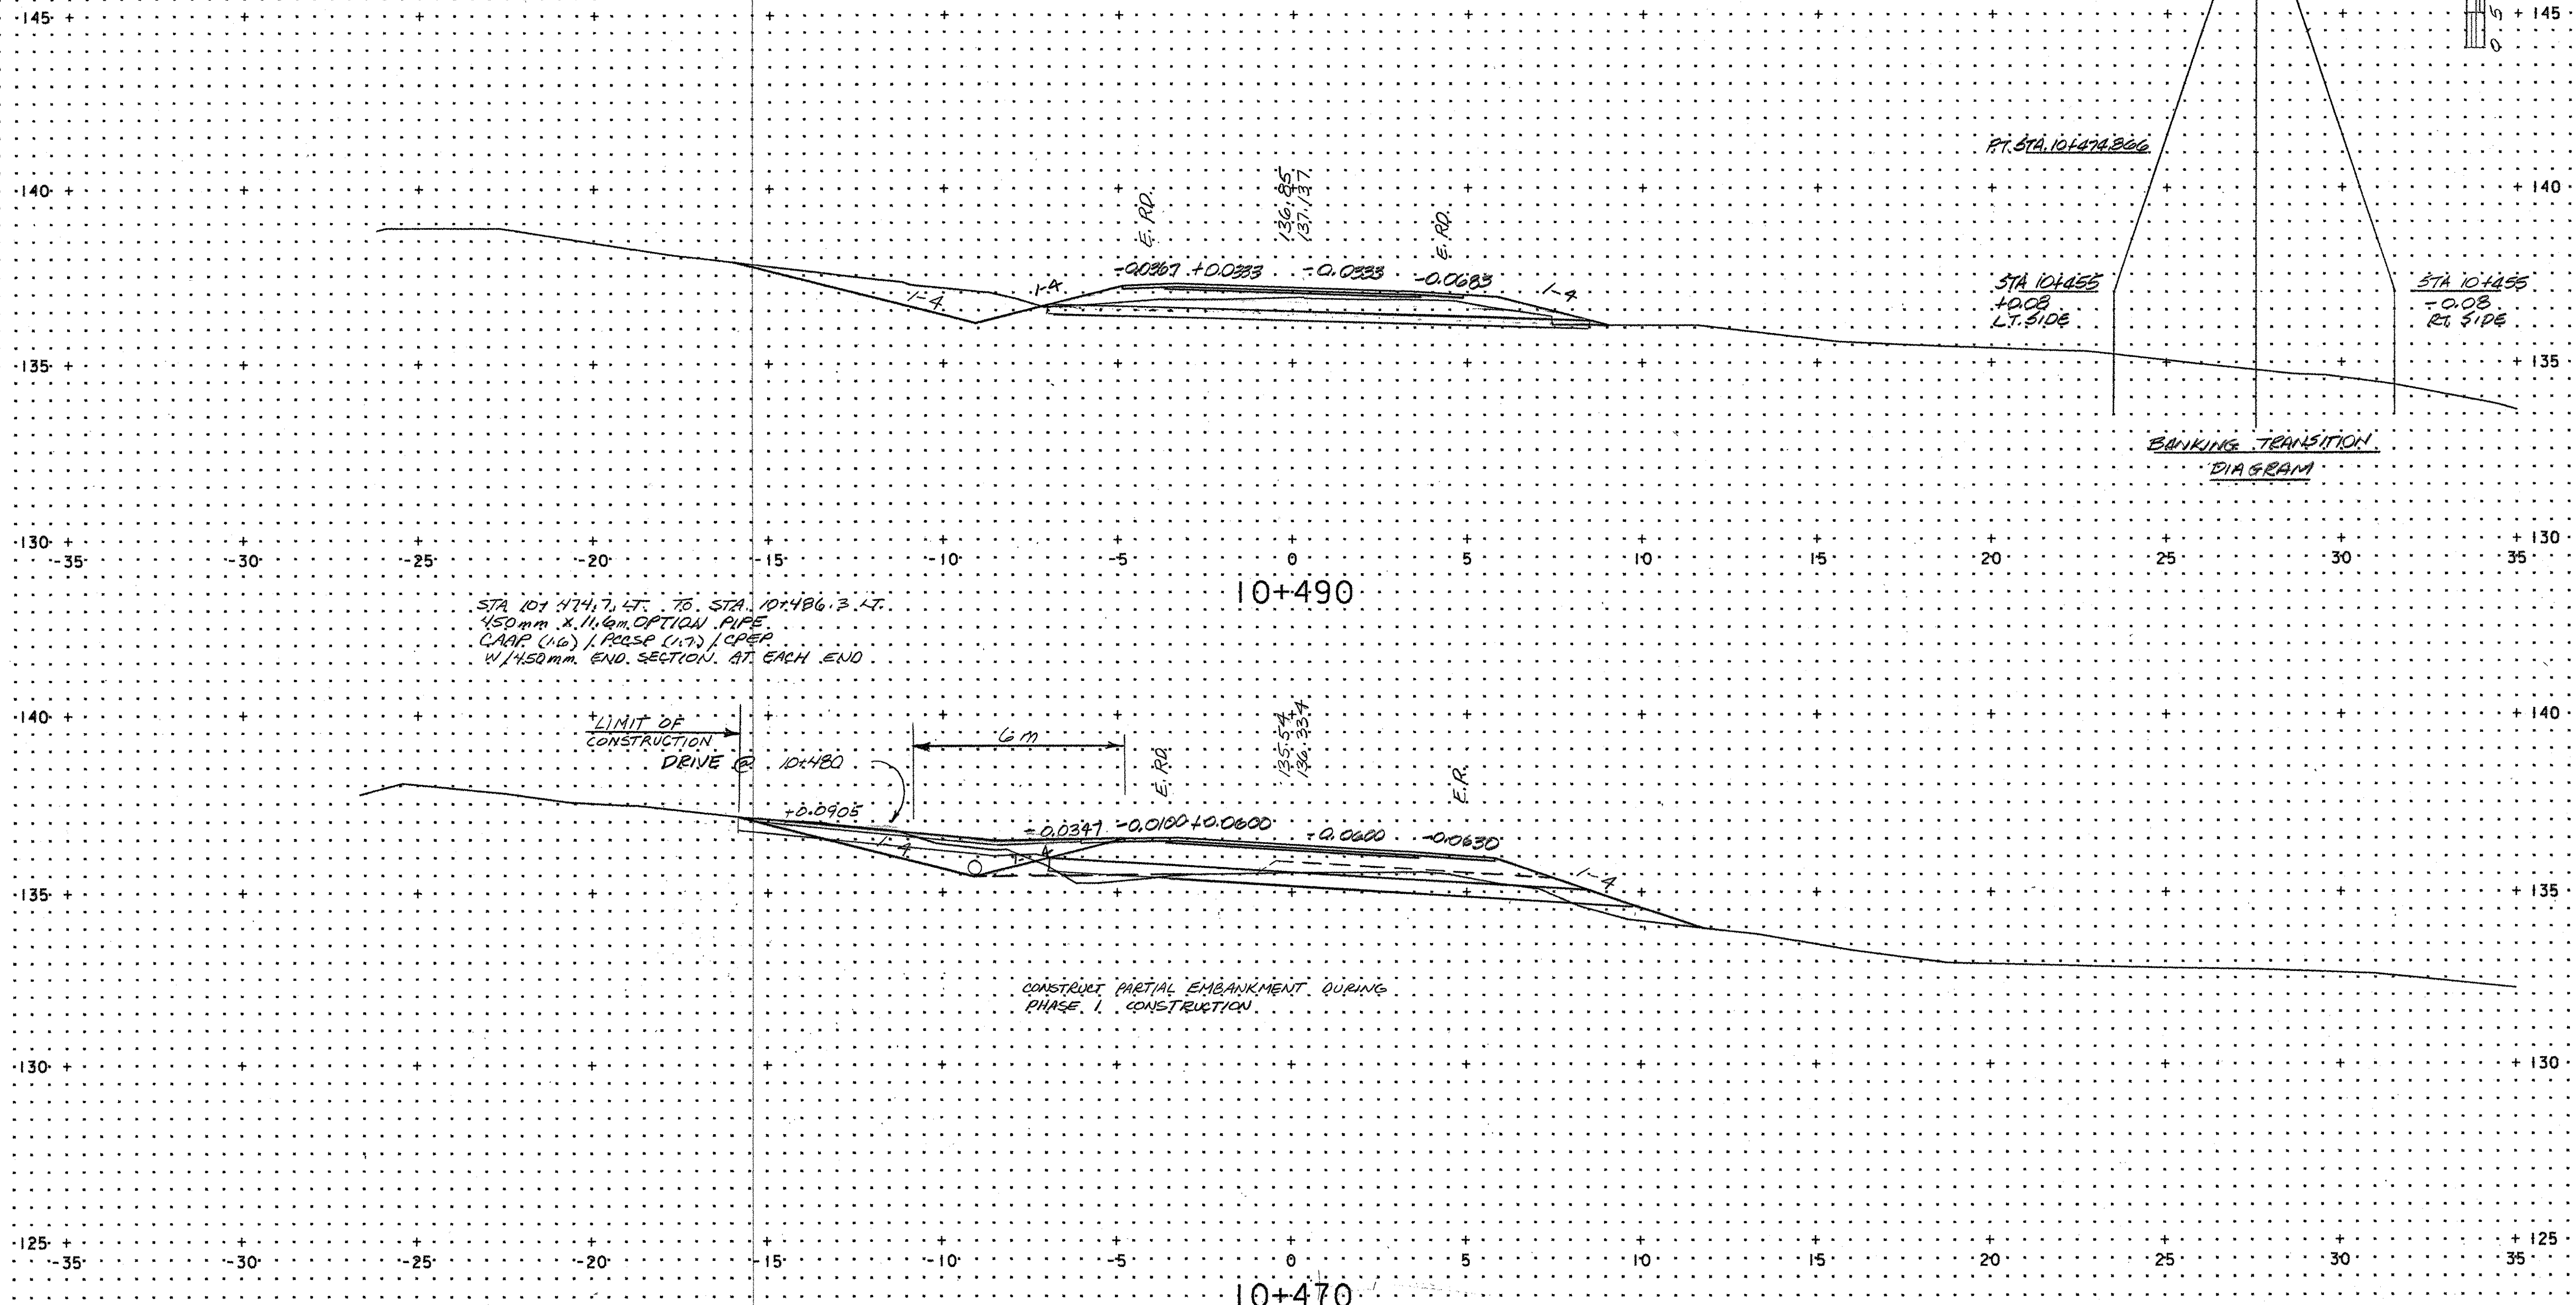


STA 10+474.7, LT. TO STA 10+486.2, RT.
 450mm x 1140m OPTICAL PIPE
 CAAP (16) / PRSP (17) / CPER
 W/ 450mm END SECTION AT EACH END

LIMIT OF CONSTRUCTION DRIVE @

CONSTRUCT PARTIAL EMBANKMENT DURING PHASE 1 CONSTRUCTION

BANKING TRANSITION DIAGRAM

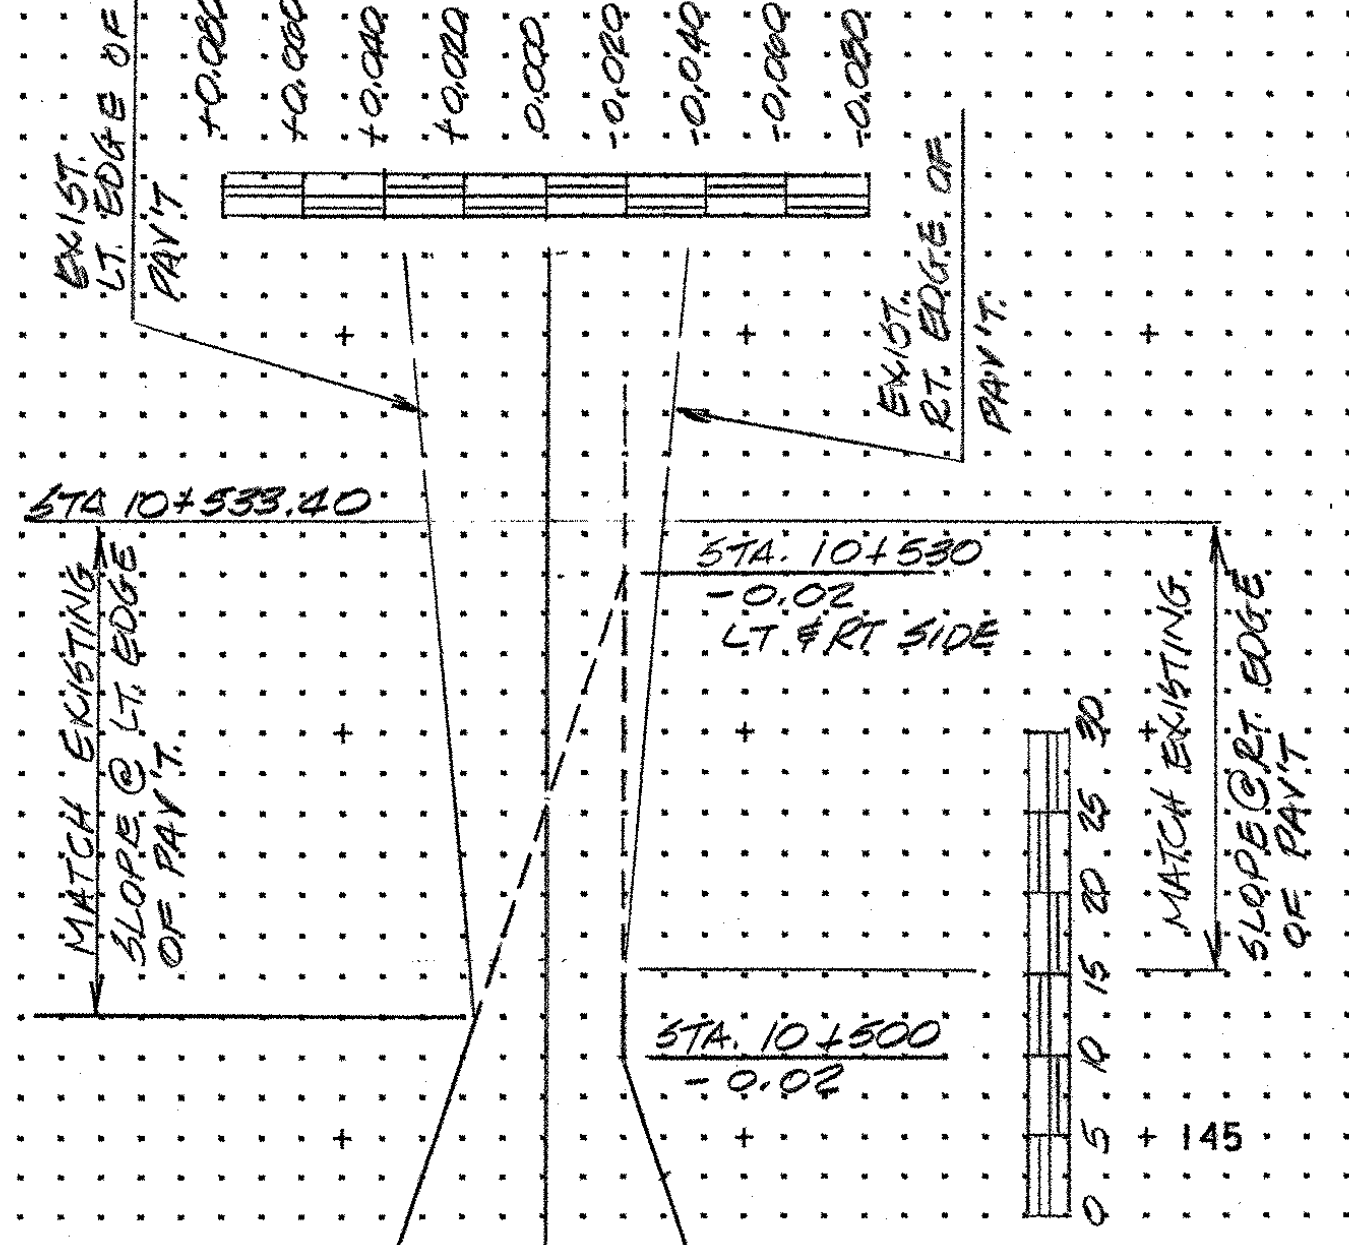

FROM STA. 10+470 TO STA. 10+490 VT. RTE. 118
 PROJECT NAME: VERMONT ROUTE 118 OVER TROUT RIVER
 PROJECT NO. BRS 0283(7)
 PLOTTED BY: CJM 10/28/96 CHECKED BY: JAV 10/29/96
 SHEET 76 OF 140 SHEETS

SCALE 1" = 1m

78f184/2f184x09