


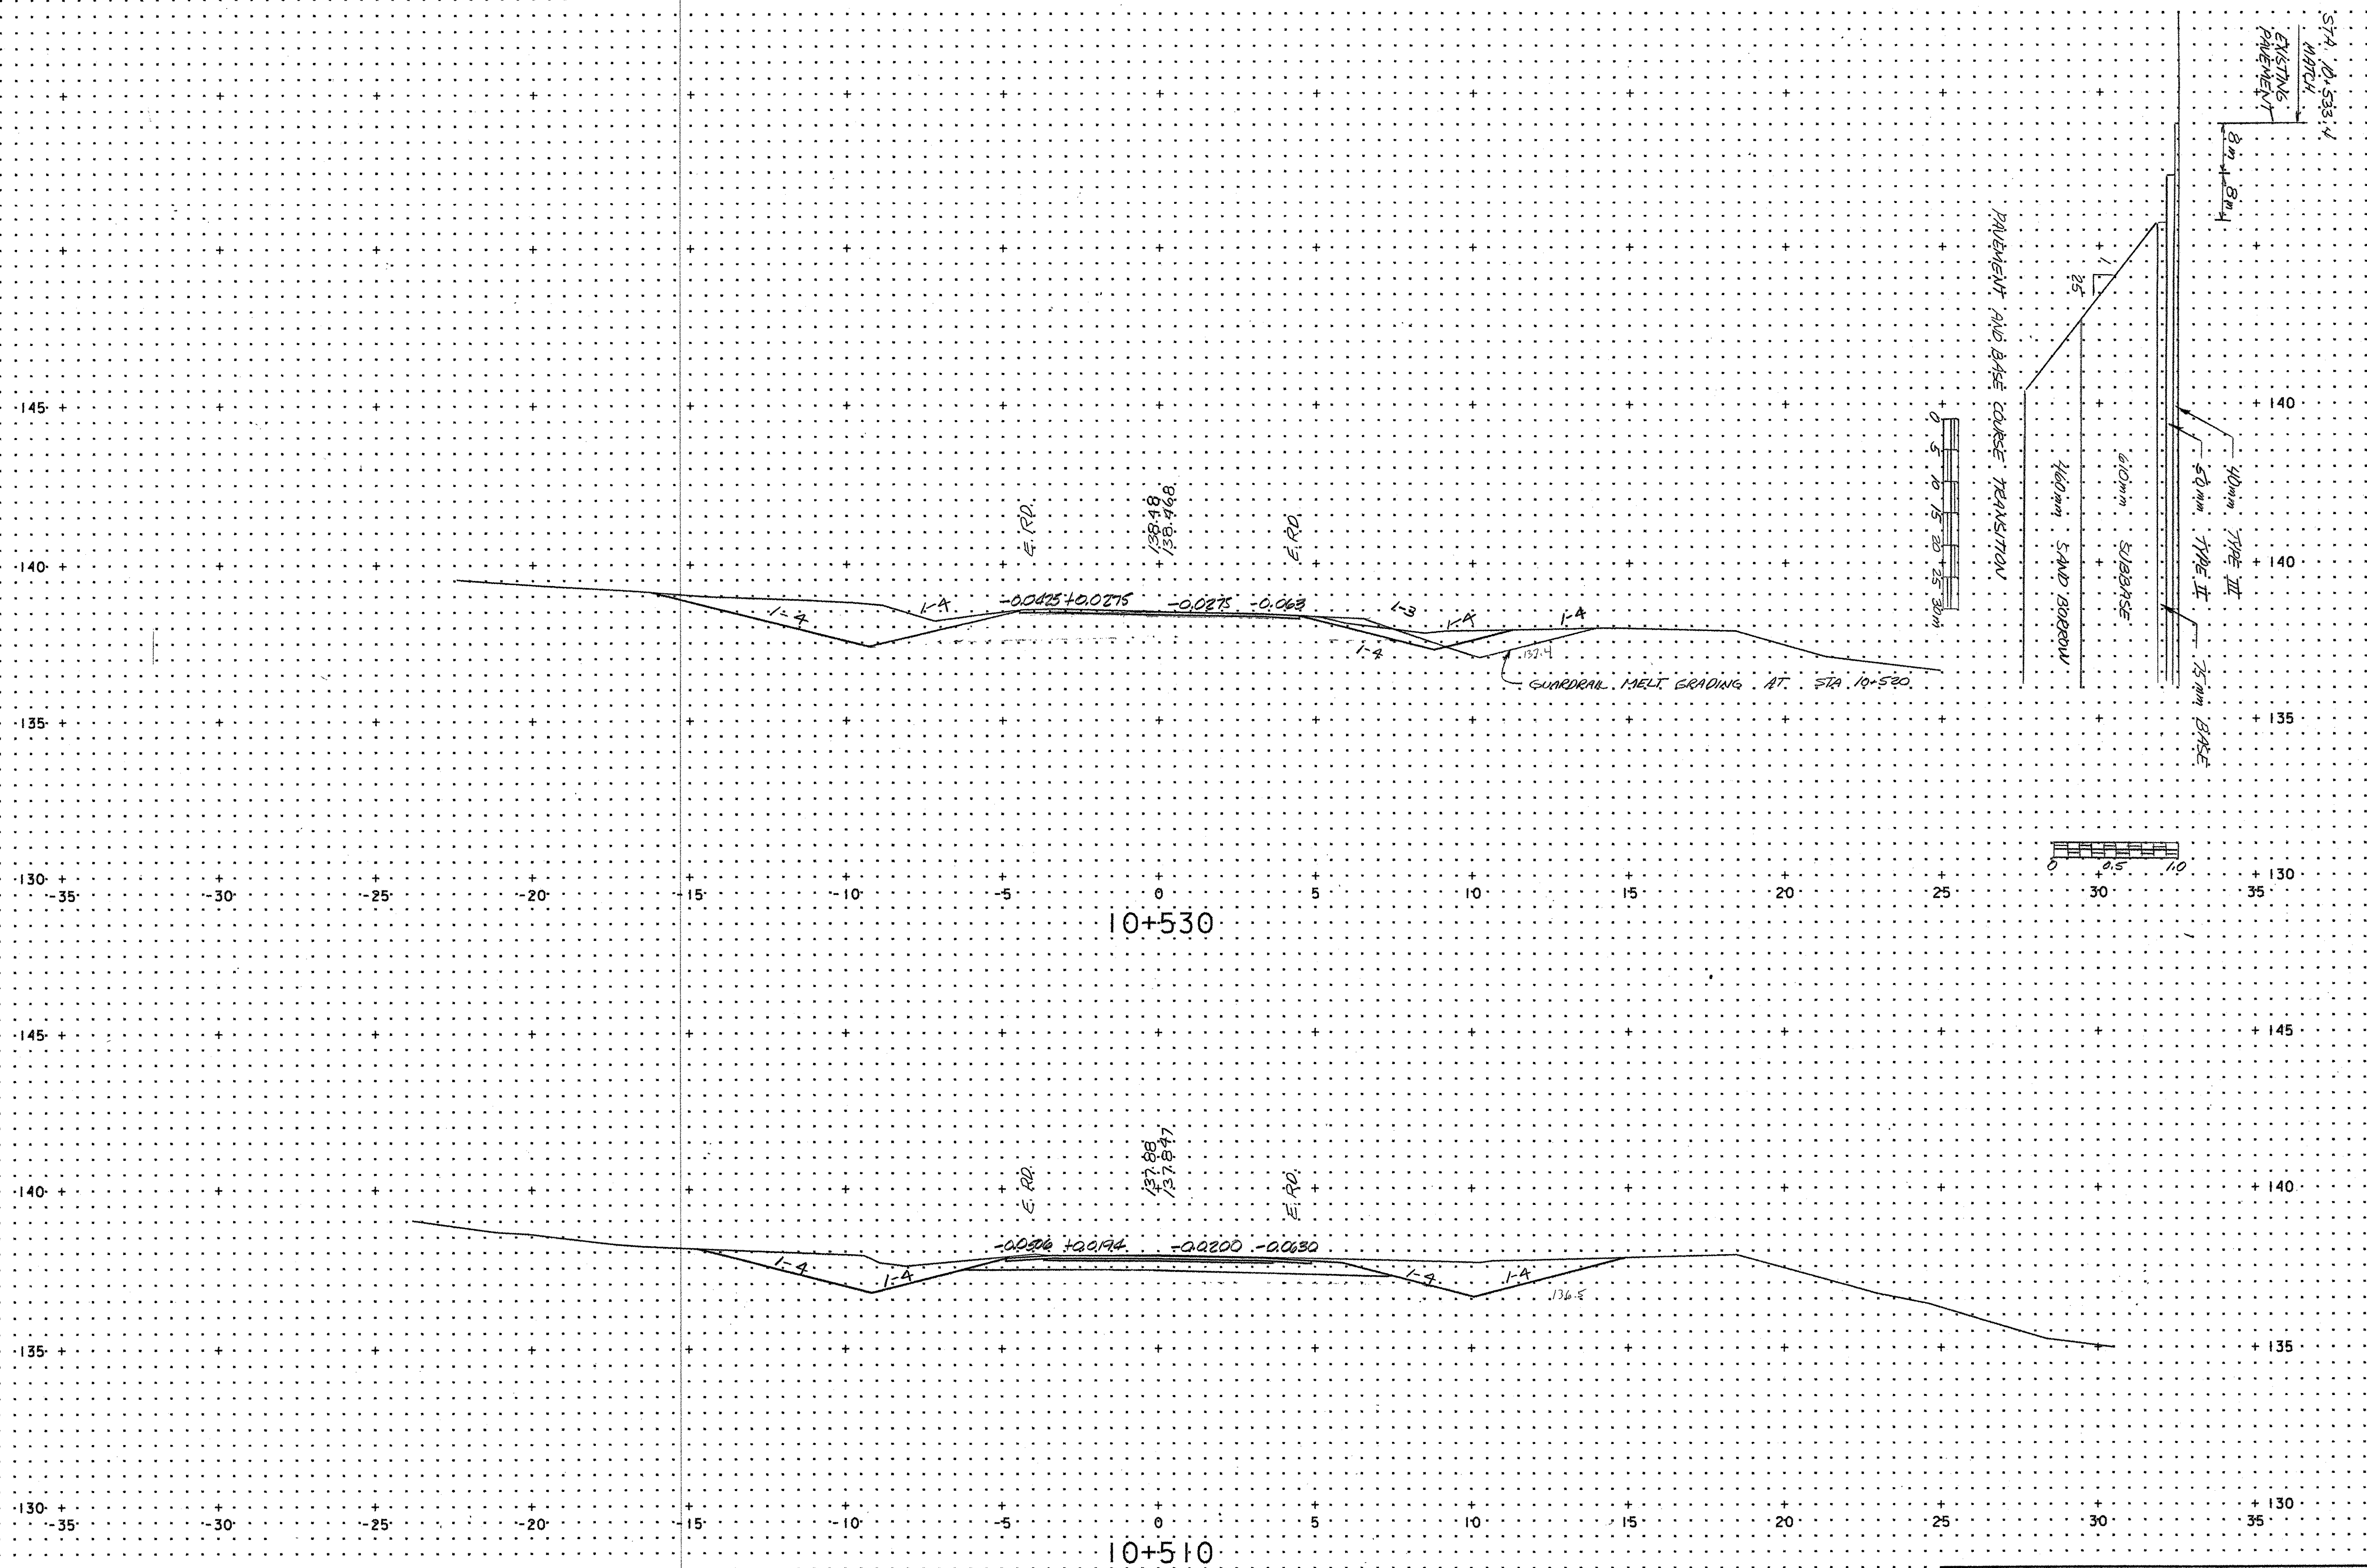

FROM STA.10+510 TO STA.10+530 VT. RTE. 118
PROJECT NAME: VERMONT ROUTE 118 OVER TROUT RIVER
PROJECT NO. BRS 0283(7)
PLOTTED BY: CJM 10/28/96 CHECKED BY: JAV 10/29/96
SHEET 77 OF 140 SHEETS