


c:\user\p45620\02837.mxd

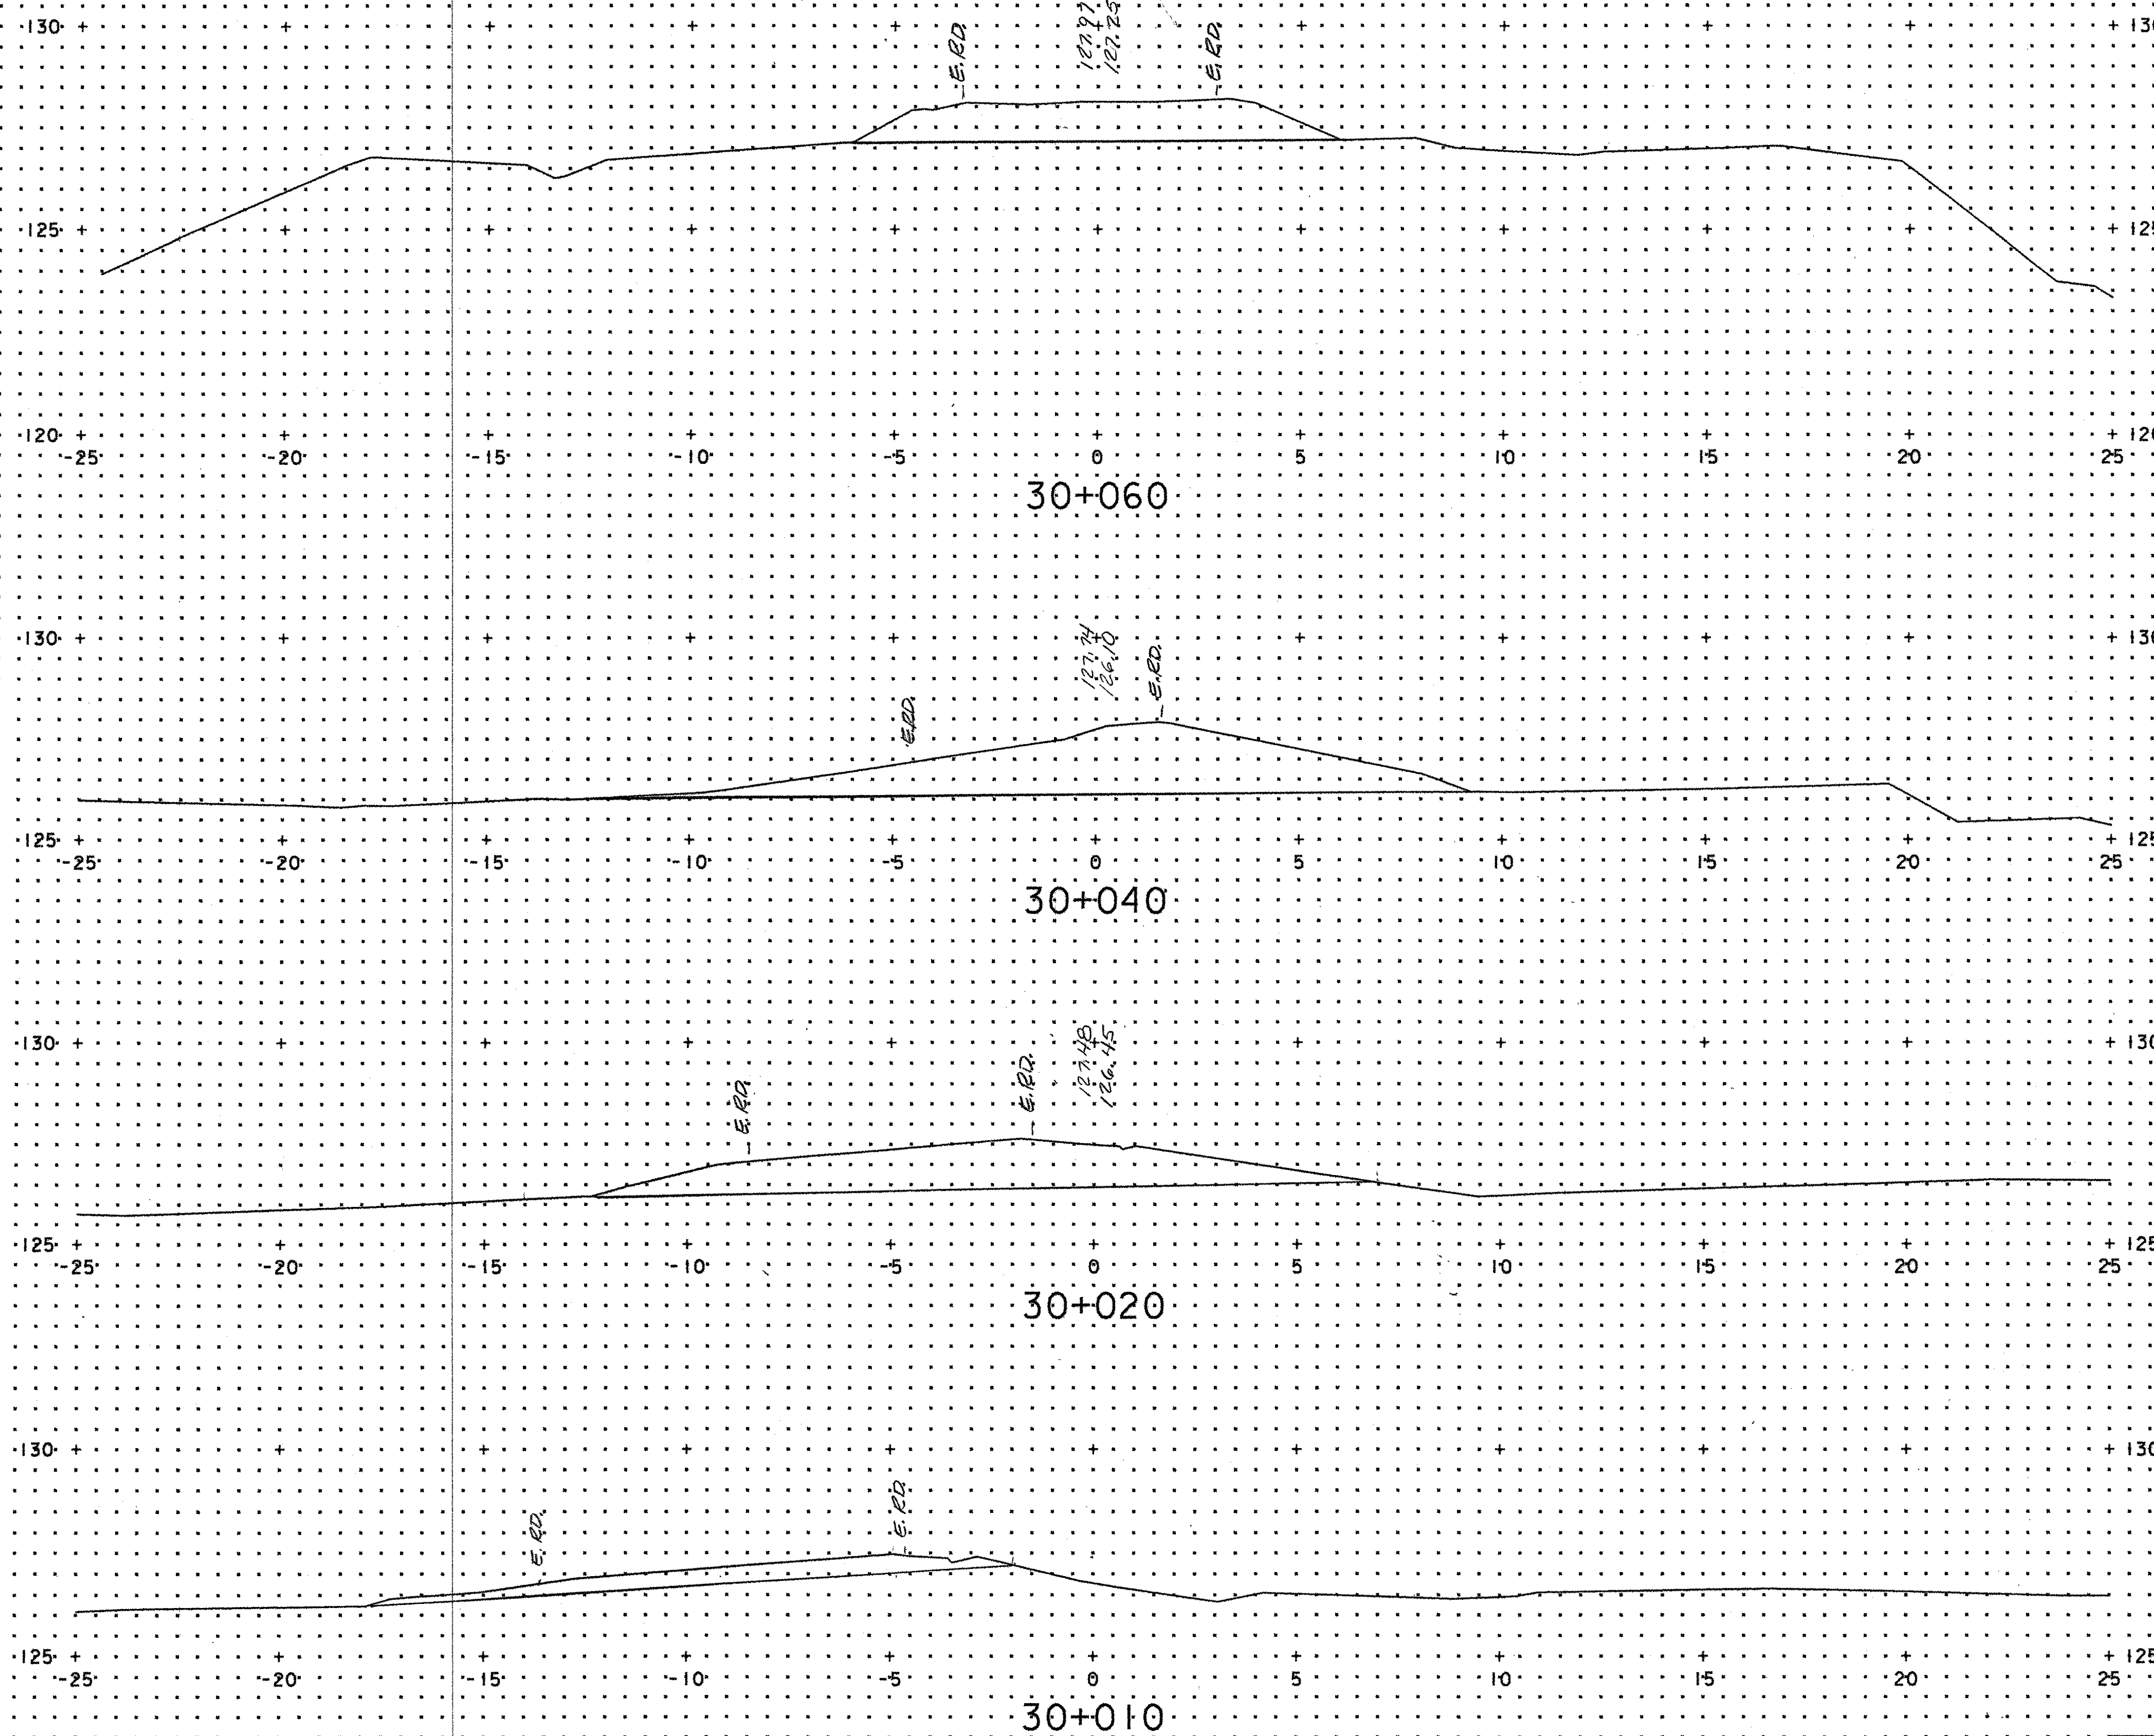

SCALE 1" = 10'

FROM STA. 30+010 TO STA. 30+060 OLD VT. RTE. 118
PROJECT NAME: VERMONT ROUTE 118 OVER TROUT RIVER
PROJECT NO. BRS 0283(7)
PLOTTED BY: CJM 10/28/96 CHECKED BY: JAV 10/29/96
SHEET 82 OF 140 SHEETS

78x104/2x104x15