
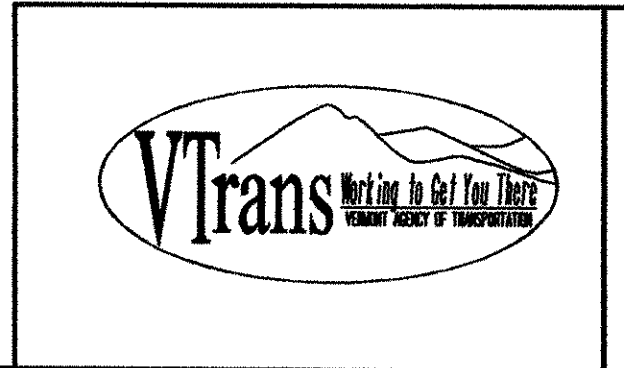


LINES SHOWN ON THIS PLAN AS EXISTING PROPERTY LINES P/L ARE BELIEVED TO BE ACCURATE BUT SHOULD NOT BE RELIED UPON FOR PURPOSES UNRELATED TO THE STATE OF VERMONT'S ACQUISITION OF LAND AND RIGHTS FOR THIS PROJECT.

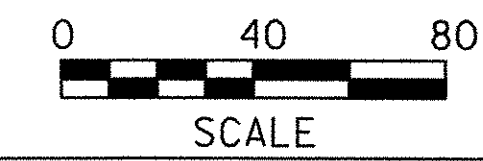

TROUT RIVER RESTORATION

PROJECT NAME:	BERKSHIRE	PLOT DATE:	16-DEC-2002
PROJECT NUMBER:	BRF-RS 0283(7)	DRAWN BY:	EGP
FILE NAME:	78f184\rightofway\ROW01.I	CHECKED BY:	
PROJECT LEADER:		SHEET	106 OF 140
DESIGNED BY:			
RIGHT-OF-WAY PLANS			

C:\p1p000\Drawings\ROW01.dwg 10/21/2002 10:41:45 AM