


- NOTES:**
1. FOR LOCATION OF STRUCTURES SEE CONSTRUCTION PLAN SHEETS.
  2. FOR DETAILS OF STRUCTURES SEE MISCELLANEOUS DETAIL SHEETS.
  3. OHW DENOTES EXISTING ORDINARY HIGH WATER.
  4. CROSS SECTIONS ARE BASED ON THALWEG STATIONING.

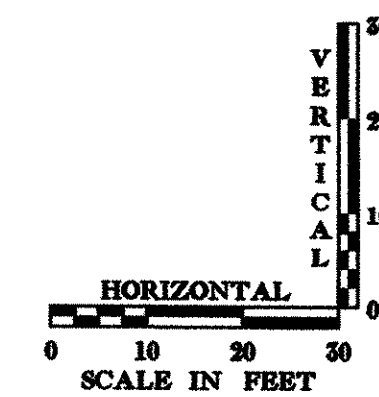

PROJECT NAME: TROUT RIVER RESTORATION  
 PROJECT NUMBER: BRF-RS 0283(7)  
 FILE NAME: z02837xsl.dgn  
 PROJECT LEADER: GAE  
 DESIGNED BY: SAR  
 CROSS SECTIONS

PLOT DATE: 04/09/2003  
 DRAWN BY: MBL  
 CHECKED BY: WCH  
 SHEET 122 OF 140

\\PLOT FILES\02837\02837.dwg 04/09/2003 11:25:37 AM