


- NOTES:**
1. FOR LOCATION OF STRUCTURES SEE CONSTRUCTION PLAN SHEETS.
 2. FOR DETAILS OF STRUCTURES SEE MISCELLANEOUS DETAIL SHEETS.
 3. OHW DENOTES EXISTING ORDINARY HIGH WATER.
 4. CROSS SECTIONS ARE BASED ON THALWEG STATIONING.

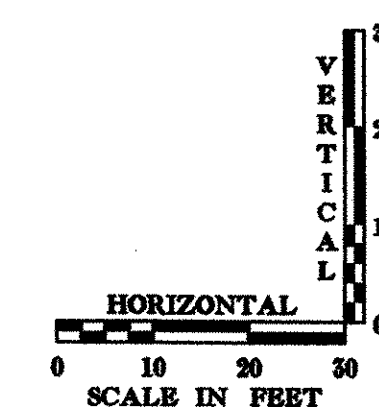

PROJECT NAME: TROUT RIVER RESTORATION
 PROJECT NUMBER: BRF-RS 0283(7)
 FILE NAME: z02837xsl.dgn
 PROJECT LEADER: GAE
 DESIGNED BY: SAR
 PLOT DATE: 04/09/2003
 DRAWN BY: MBL
 CHECKED BY: WCH
 SHEET 125 OF 140

C:\PDR\Files\Projects\0283\0283.dwg 14/09/2003 11:26:11 AM