


- NOTES:**
1. FOR LOCATION OF STRUCTURES
SEE CONSTRUCTION PLAN SHEETS.
 2. FOR DETAILS OF STRUCTURES
SEE MISCELLANEOUS DETAIL SHEETS.
 3. OHW DENOTES EXISTING ORDINARY
HIGH WATER.
 4. CROSS SECTIONS ARE BASED ON
THALWEG STATIONING.

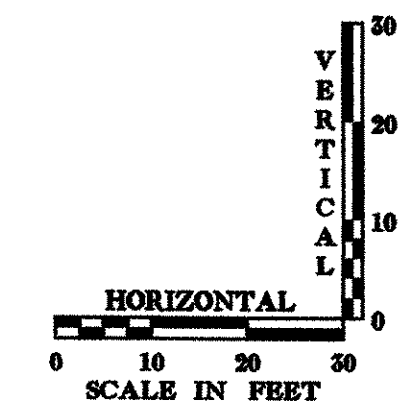

	PROJECT NAME: TROUT RIVER RESTORATION	
	PROJECT NUMBER: BRF-RS 0283(7)	
FILE NAME: z02837xsl.dgn	PLOT DATE: 04/09/2003	
PROJECT LEADER: GAE	DRAWN BY: MBL	
DESIGNED BY: SAR	CHECKED BY: WCH	
CROSS SECTIONS	SHEET 126 OF 140	

\\P:\BKF\Files\0283\cross\126.dwg 04/09/2003 11:56:19 AM