


- NOTES:**
1. FOR LOCATION OF STRUCTURES SEE CONSTRUCTION PLAN SHEETS.
 2. FOR DETAILS OF STRUCTURES SEE MISCELLANEOUS DETAIL SHEETS.
 3. OHW DENOTES EXISTING ORDINARY HIGH WATER.
 4. CROSS SECTIONS ARE BASED ON THALWEG STATIONING.

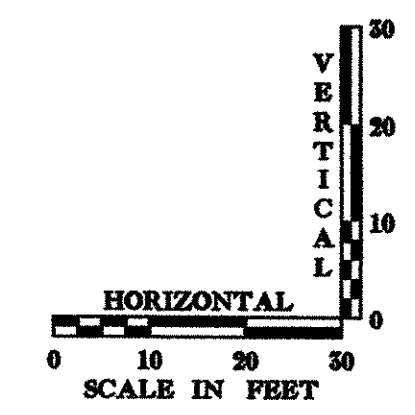

	PROJECT NAME: TROUT RIVER RESTORATION	
	PROJECT NUMBER: BRF-RS 0283(7)	
	FILE NAME: z02837xsl.dgn	PLOT DATE: 04/09/2003
	PROJECT LEADER: GAE	DRAWN BY: MBL
DESIGNED BY: SAR	CHECKED BY: WCH	
CROSS SECTIONS		SHEET 127 OF 140

C:\PLOT_FILES\08\CROSSSECTIONS.DWT 04/09/2003 11:56:25 AM