


- NOTES:**
1. FOR LOCATION OF STRUCTURES SEE CONSTRUCTION PLAN SHEETS.
 2. FOR DETAILS OF STRUCTURES SEE MISCELLANEOUS DETAIL SHEETS.
 3. OHW DENOTES EXISTING ORDINARY HIGH WATER.
 4. CROSS SECTIONS ARE BASED ON THALWEG STATIONING.

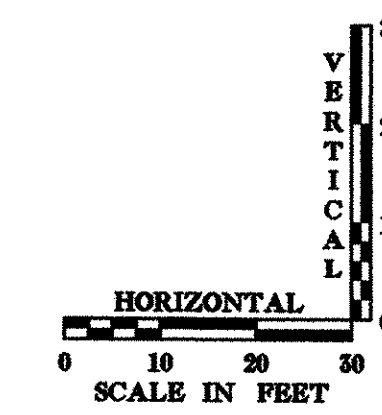

	PROJECT NAME: TROUT RIVER RESTORATION	PLOT DATE: 08/26/2003
	PROJECT NUMBER: BRF-RS 0283(7)	DRAWN BY: MBL
	FILE NAME: z02837xsl.dgn	CHECKED BY: WCH
	PROJECT LEADER: GAE	SHEET 128 OF 140
	DESIGNED BY: SAR	
	CROSS SECTIONS	