


- NOTES:
1. FOR LOCATION OF STRUCTURES
SEE CONSTRUCTION PLAN SHEETS.
 2. FOR DETAILS OF STRUCTURES
SEE MISCELLANEOUS DETAIL SHEETS.
 3. OHW DENOTES EXISTING ORDINARY
HIGH WATER.
 4. CROSS SECTIONS ARE BASED ON
THALWEG STATIONING.

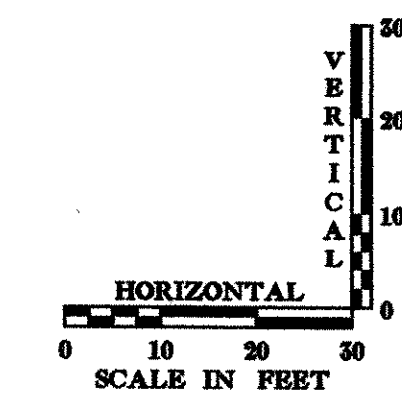

	PROJECT NAME: TROUT RIVER RESTORATION	PLOT DATE: 08/26/2003
	PROJECT NUMBER: BRF-RS 0283(7)	DRAWN BY: MBL
	FILE NAME: z02837x.sl.dgn	CHECKED BY: WCH
	PROJECT LEADER: GAE	SHEET 131 OF 140
DESIGNED BY: SAR	CROSS SECTIONS	