


- NOTES:**
1. FOR LOCATION OF STRUCTURES
SEE CONSTRUCTION PLAN SHEETS.
 2. FOR DETAILS OF STRUCTURES
SEE MISCELLANEOUS DETAIL SHEETS.
 3. EXISTING CHANNEL BOTTOM GEOMETRY FOR
STA. 29+00 AND 30+00 IS NOT KNOWN
DUE TO ICE COVER AT THE TIME OF
SURVEY. EXISTING CHANNEL BOTTOM
GEOMETRY AT STA. 29+00 AND 30+00
IS ASSUMED.
 4. OHW DENOTES EXISTING ORDINARY
HIGH WATER.
 5. CROSS SECTIONS ARE BASED ON
THALWEG STATIONING.

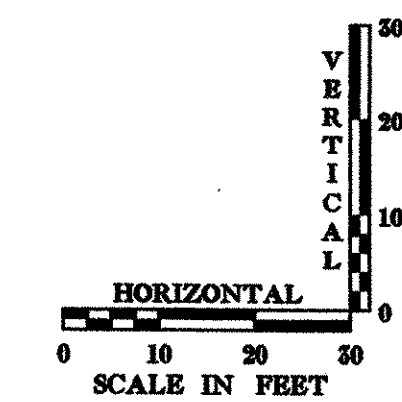

PROJECT NAME: TROUT RIVER RESTORATION
PROJECT NUMBER: BR-F-RS 0283(7)

FILE NAME: z02837xsl.dgn
PROJECT LEADER: GAE
DESIGNED BY: SAR
CROSS SECTIONS

PLOT DATE: 08/26/2003
DRAWN BY: MBL
CHECKED BY: WCH
SHEET 132 OF 140