


LEGEND

- PHASE II CONSTRUCTION
- VEHICLE TRACKING PAD
- SILT FENCE
- ROCK BARRIER INLET PROTECTION
- ROCK BARRIER CULVERT INLET PROTECTION
- SETTLING STRUCTURE

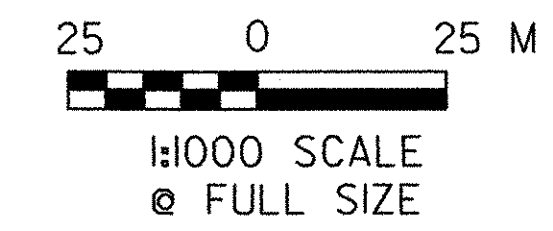

EROSION PREVENTION AND SEDIMENT CONTROL - PHASE II

1. AN ALTERNATE EROSION PREVENTION AND SEDIMENT CONTROL PLAN MAY BE SUBMITTED BY THE CONTRACTOR (PRIOR TO THE START OF CONSTRUCTION) FOR APPROVAL BY THE ENGINEER, THE VTRANS DIRECTOR OF PROGRAM DEVELOPMENT AND THE AGENCY OF NATURAL RESOURCES. IF AN ALTERNATE PLAN IS SUBMITTED, CONSTRUCTION WILL NOT BE ALLOWED UNTIL WRITTEN APPROVAL IS OBTAINED FROM ALL AFOREMENTIONED ENTITIES.
2. TRANSFER TRAFFIC TO PROPOSED BRIDGE AND COMMENCE PHASE II CONSTRUCTION. SEE THE TRAFFIC CONTROL PLANS FOR LIMITS AND DETAILS OF PHASE II WORK.
3. CLEAR THE SITE AS REQUIRED FOR PHASE II AND PHASE III OF THE BRIDGE REPLACEMENT PORTION OF THE PROJECT.
4. INSTALL PHASE II TEMPORARY EROSION PREVENTION AND SEDIMENT CONTROL MEASURES, AS SHOWN, AS REQUIRED, OR AS DIRECTED BY THE ONSITE COORDINATOR, IN THE FOLLOWING ORDER:
 - A. DIVERSION STRUCTURES (DIVERSION DIKES OR CHANNELS).
 - B. FILTER BARRIERS (SILT FENCE OR GEOSYNTHETIC BARRIERS - SEE EROSION CONTROL DETAIL SHEETS FOR CONSTRUCTION NOTES AND DETAILS).
5. GRUB THE PHASE II SITE. STUMPS, EXCESS SOILS AND OTHER WASTE MATERIAL SHALL BE DISPOSED OF IN A LOCATION APPROVED BY THE ONSITE COORDINATOR, THE AGENCY OF NATURAL RESOURCES, THE VTRANS BIOLOGIST AND THE VTRANS ARCHEOLOGIST.
6. COMPLETE PHASE II CONSTRUCTION OF PROPOSED BRIDGE. SEE BRIDGE REPLACEMENT PLANS.
 - A. AS CONSTRUCTION PROGRESSES IMPLEMENT ADDITIONAL TEMPORARY EROSION CONTROLS AS SHOWN, AS REQUIRED, OR AS DIRECTED BY THE ONSITE COORDINATOR, INCLUDING TEMPORARY BERMS AND FLEXIBLE SLOPE DRAINS, STONE CHECK DAMS, SEEDING AND MULCHING, SEDIMENT SETTLING STRUCTURES, ROCK BARRIER INLET PROTECTION AND ROCK BARRIER CULVERT INLET PROTECTION.
 - B. INSPECT AND MAINTAIN EROSION PREVENTION AND SEDIMENT CONTROL MEASURES IN ACCORDANCE WITH THE SPECIFICATIONS AND SPECIAL PROVISIONS.
 - C. DISPOSE OF COLLECTED SEDIMENT AND OTHER POLLUTANTS IN A MANNER APPROVED BY THE ENGINEER THAT WILL NOT RESULT IN SEDIMENTS AND POLLUTANTS ENTERING WATERS OF THE STATE.
7. PERMANENTLY AND IMMEDIATELY STABILIZE ALL FINISHED GRADES AS EARTHWORK IS COMPLETED INCLUDING CHANNEL LININGS, SEEDING AND MULCHING (PERMANENT TURF ESTABLISHMENT) AND PERMANENT STONE FILL FOR SLOPE STABILIZATION.
8. FOR ADDITIONAL EROSION PREVENTION AND SEDIMENT CONTROL NOTES SEE EROSION CONTROL PLAN 4.



PROJECT NAME: TROUT RIVER RESTORATION
 PROJECT NUMBER: BRF-RS 0283 (7)
 FILE NAME: ...02837ESC2.p+f PLOT DATE: 08/26/2003
 PROJECT LEADER: GAE DRAWN BY: PZA
 DESIGNED BY: SAR CHECKED BY: WCH
EROSION CONTROL PLAN 2 SHEET 137 OF 140

VP:BT 7/15/03 02837ESC2.BIT 08/26/2003 08:36:08 AM