


Fill slope at 10+290 13m RT
 125.3 m (from section)
 COMPUTE FILL SLOPE 14m LEFT AT 10+280
 4-GRADE = 130.257
 Slope Elev = $130.257 + .042(3.5) - .042(2.3) - 8.2(.646)$
 = 124.79

$TAN \theta = \frac{5.80}{9.20} = 2.6363636$
 $\theta = 69.228^\circ$
 $SIN 69.228^\circ = \frac{5.80}{9.34999}$
 $X = \frac{5.80}{.934999} = 6.20'$

COMPUTE 10+283 LT SHOULDER
 STA ELEV @ E
 10+280 130.257
 10+283 130.270
 10+290 130.296
 LT SHOULDER = $130.270 + .032(3.5) - .032(2.3)$
 = 130.295

COMPUTE 10+285.2 @ 4
 STA ELEV @ E
 10+280 130.257
 10+285.2 130.278
 10+290 130.296

COMPUTE 10+287.3 RT SHOULDER
 STA ELEV @ E
 10+280 130.257
 10+287.3 130.286
 10+290 130.296
 RT SHOULDER = $130.286 - .038(3.5) - 2.3(.646)$
 = 130.008

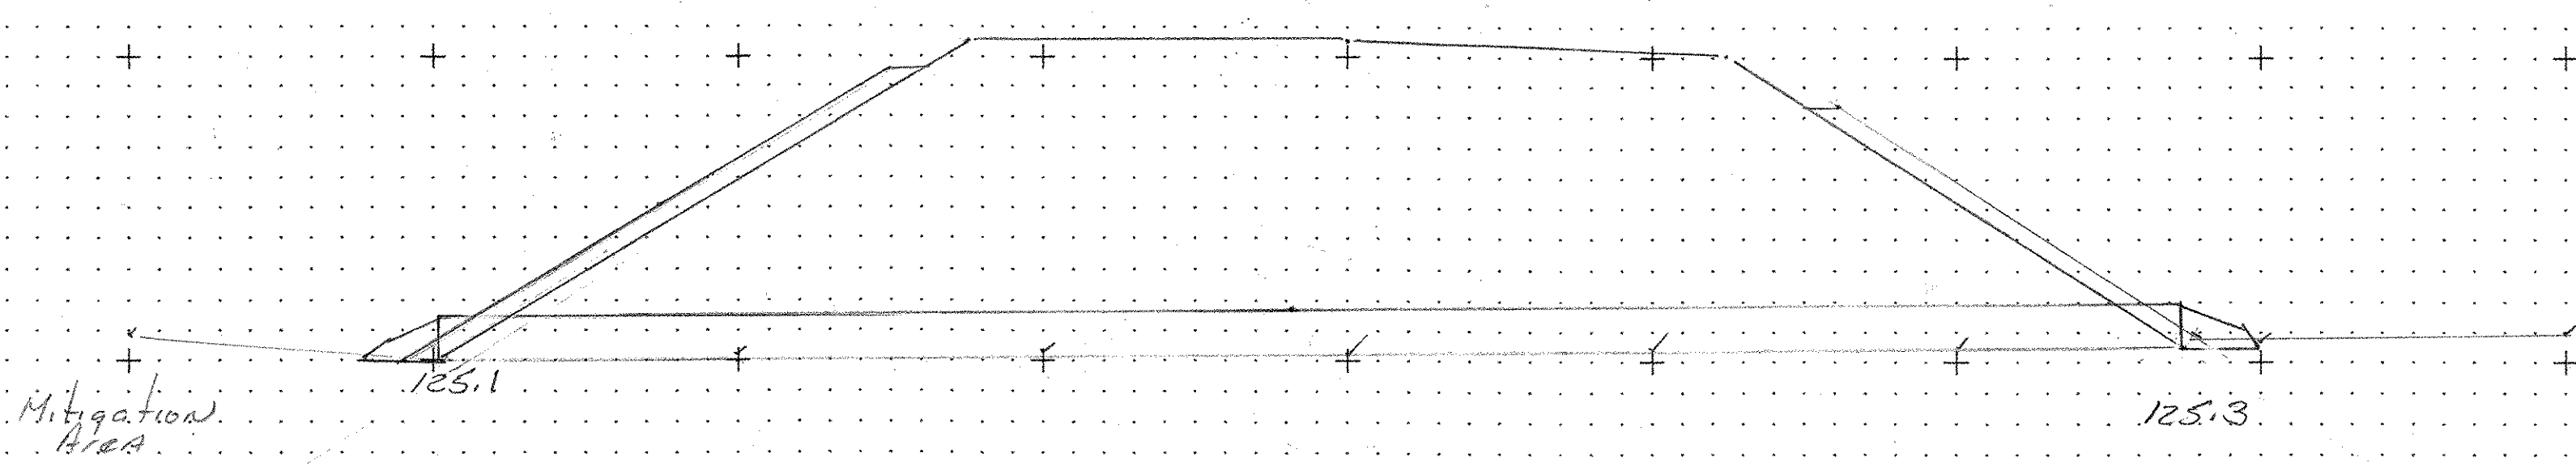

10+285.2 (SKEW RT 69.228°)
 New 750 X 28.65 CPEP
 0m³ Trench Excavation
 See Drainage Summary sheet