


TYPICAL END CROSSFRAME
(@ ABUTMENTS, AWAY FROM BACKWALL)

(END CROSSFRAMES AT ABUTMENT 2 SHALL BE PAINTED- BOLTS SHALL BE A325-1 GALV)

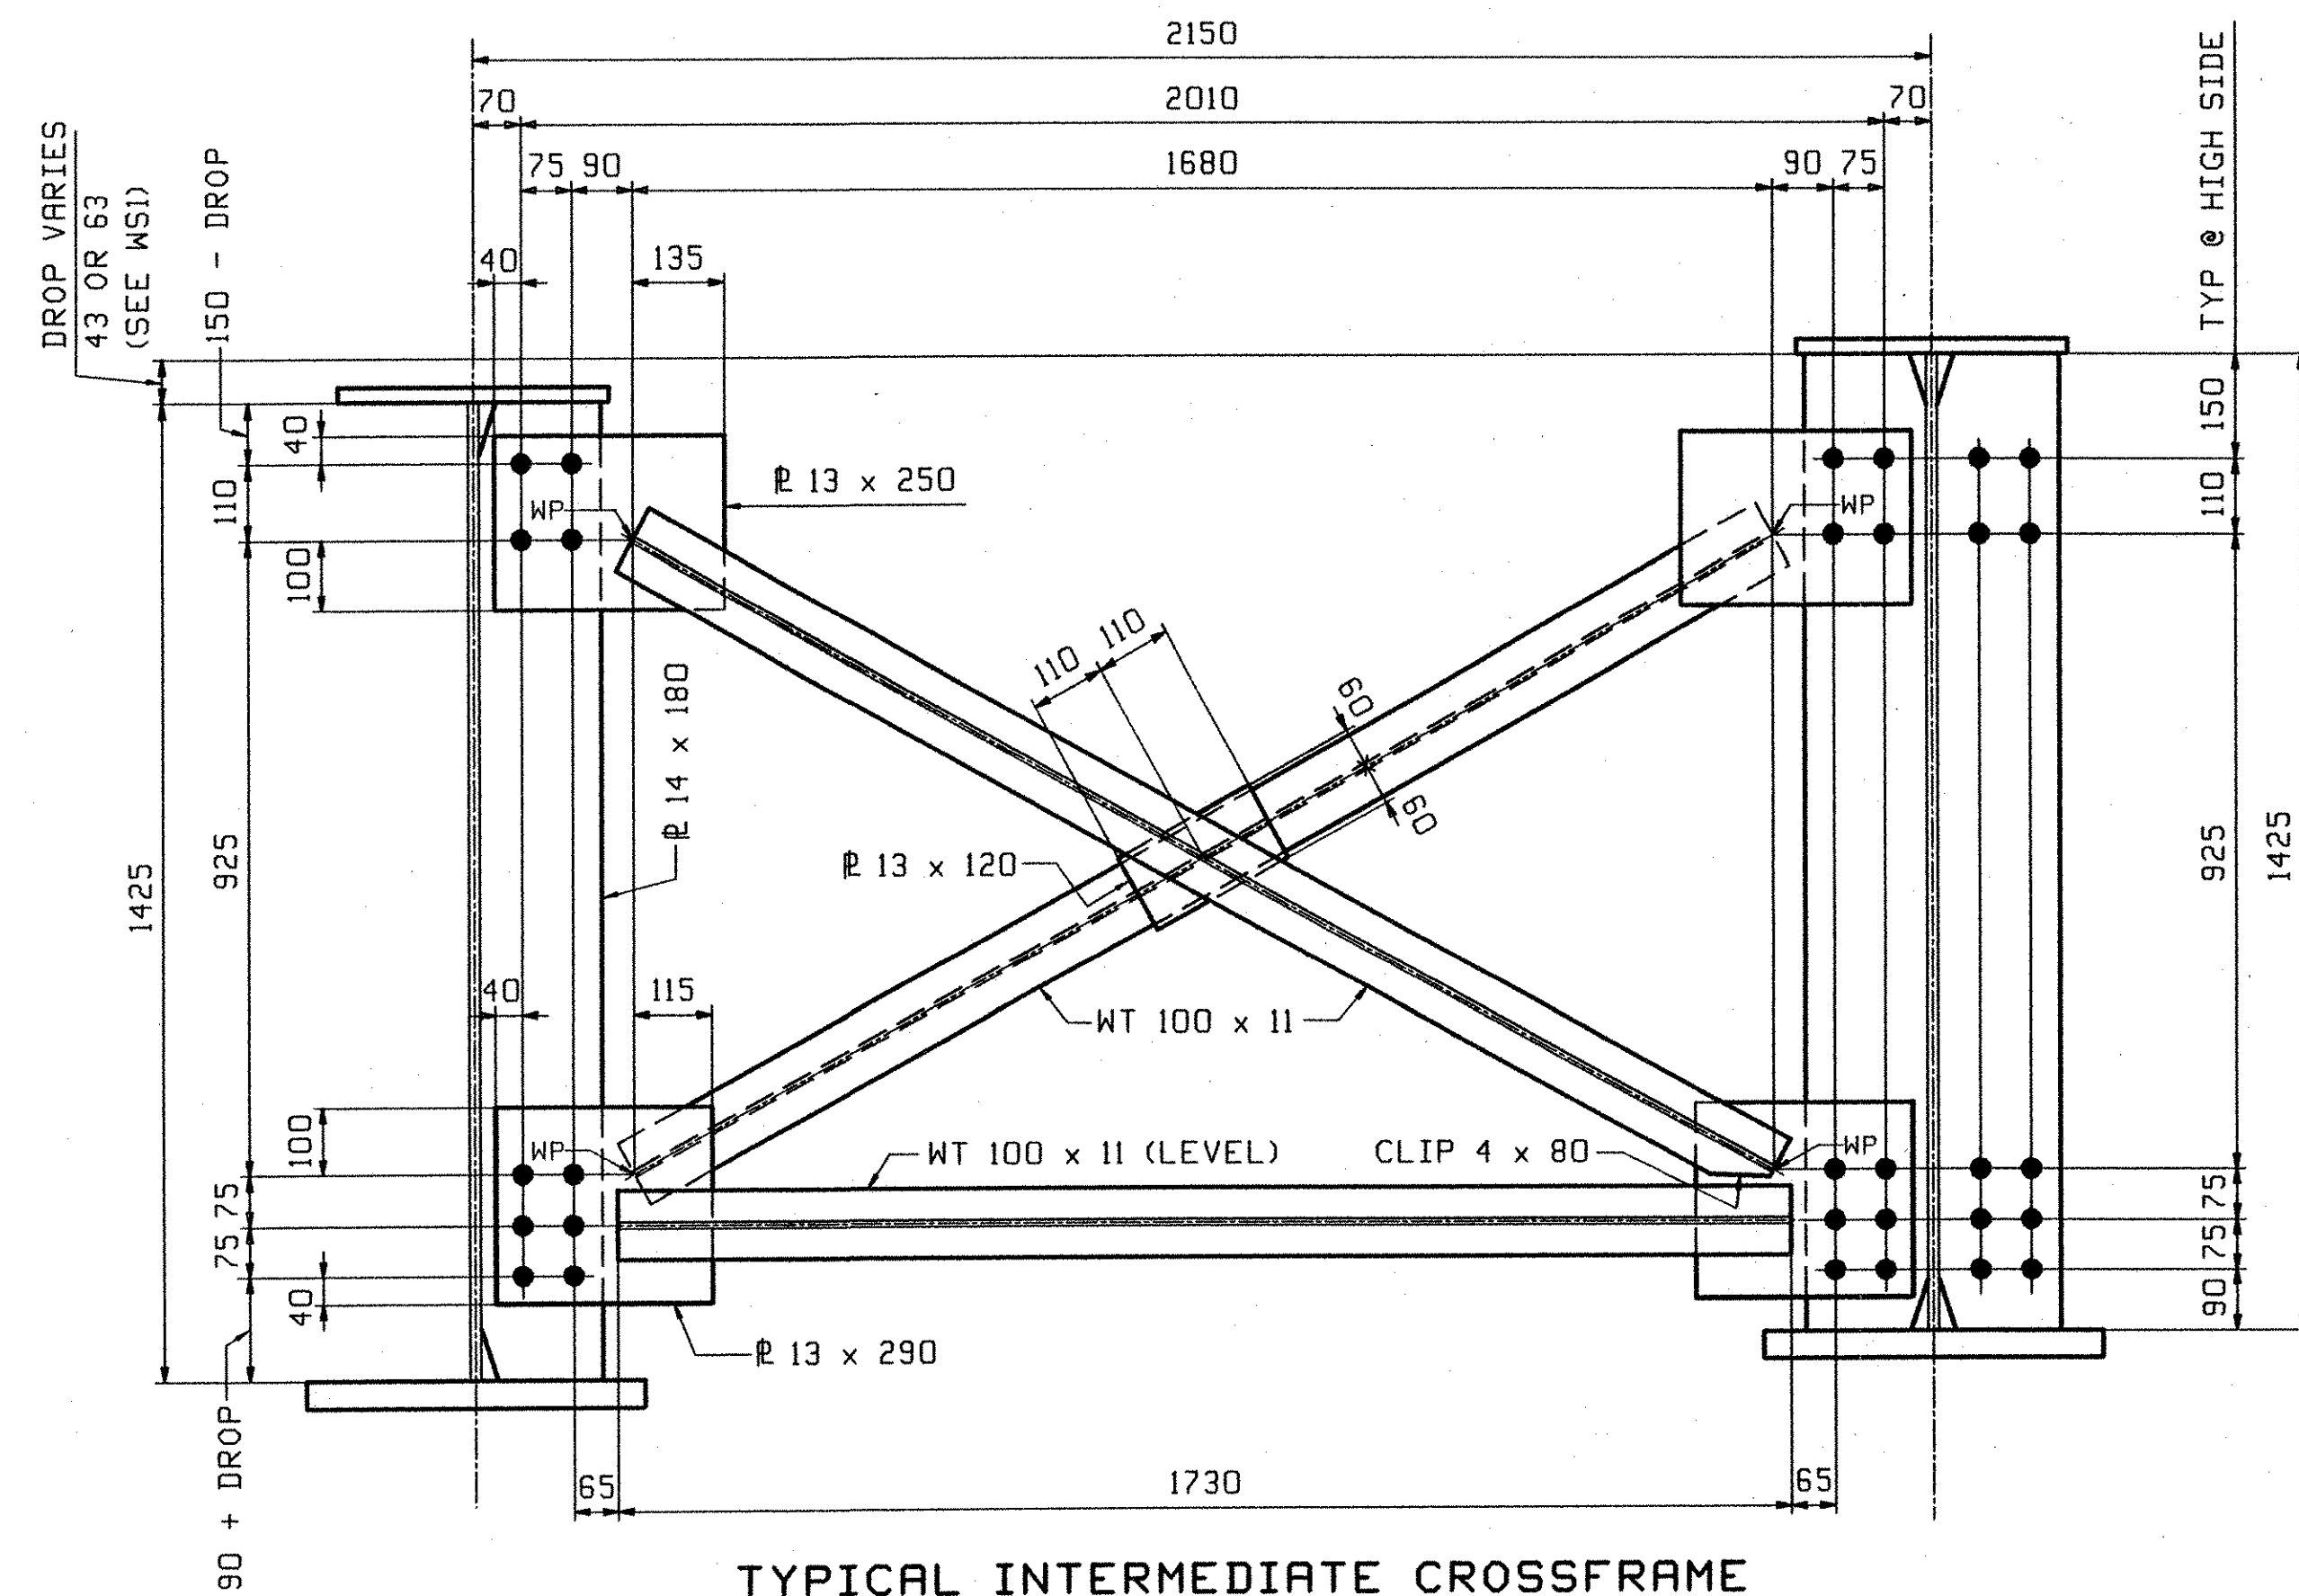

TYPICAL INTERMEDIATE CROSSFRAME
(LOOKING UP STATION)

**** NOTE ****
THE PURPOSE OF THIS DRAWING IS TO COORDINATE GEOMETRIC CONTROL INFORMATION AND CONNECTION SPACING. THIS DWG IS SUBMITTED FOR INFORMATION ONLY & IS NOT INTENDED FOR SHOP FABRICATION. DETAIL DWGS WILL SHOW ALL WELDING AND DIMENSIONS REQ'D FOR FABRICATION.

- Reviewed
- Rejected
- Furnish as Corrected
- Revise and Resubmit
- Submit Specified Item

This review is only for general conformance with the design concept and the information given in the Construction Documents. Corrections or comments made on the shop drawings during this review do not relieve the contractor from compliance with the requirements of the plans and specifications. Review of a specific item shall not indicate review of an assembly of which the item is a component. The Contractor is responsible for dimensions to be confirmed and correlated at the jobsite. Information that pertains solely to the fabrication process or to the means, methods, techniques, sequences and procedures of construction, coordination of the Work with that of all other trades and performing all work in a safe and satisfactory manner.

RECEIVED
OCT 20 2004
BY: *[Signature]* DATE: 11-01-04

McAuland-Johnson, Inc.
Date: *10/16/04*
By: *Sтивен F. Делья*

OUT FOR APPROVAL	9/20/04								
OUT FOR APPROVAL									
ISSUED TO SHOP									
FIELD & OFFICE									

REV.	REMARKS	DATE	DWN	CHK	APP	Q.A.	NO.	DIA.	LGT	TYPE	WASHER
MATERIAL:	M270M-345W	ELECTRODES:									
		HOLES:	15/16"Ø								
			(24mm)								
		SHOP BOLTS:	7/8" A325-3 (UN)								

SURFACE PREP. & PAINT:
STEEL WITHIN 2450 OF ABUTMENT 2 SHALL BE PAINTED PER NOTES ON GNI. ALL OTHER STEEL SHALL BE UNPAINTED.

DESCRIPTION:	CROSSFRAME LAYOUTS	DRAWN BY:	DATE
JOB:	VT. ROUTE 118 OVER TROUT RIVER	CHKD BY:	07/09
	TOWN OF BERKSHIRE, VT	APPROV BY:	07/22
	FRANKLIN COUNTY	SUPERVISOR:	M. J. GATTI
PROJ NO.	BRF-RS 0283(7)	Q.A.	
CUSTOMER:	A.L. ST. ONGE		

CASCO BAY STEEL STRUCTURES, INC.		JOB NO.	DRG. NO.
75 SPRING HILL ROAD SACO, MAINE 04072		222	TD1
PHONE (207) 282-7360 FAX. (207) 282-1179		15255	REV. △

SCALE 1:10