



16 ~ x1a
BRG STIFF.

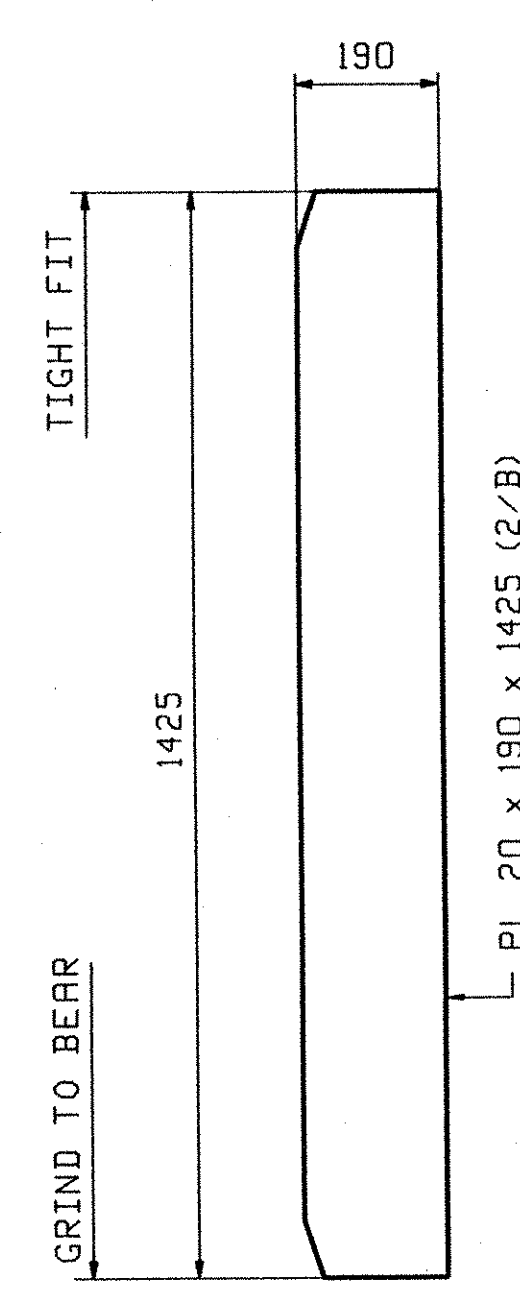


4 ~ x1b
BRG STIFF.

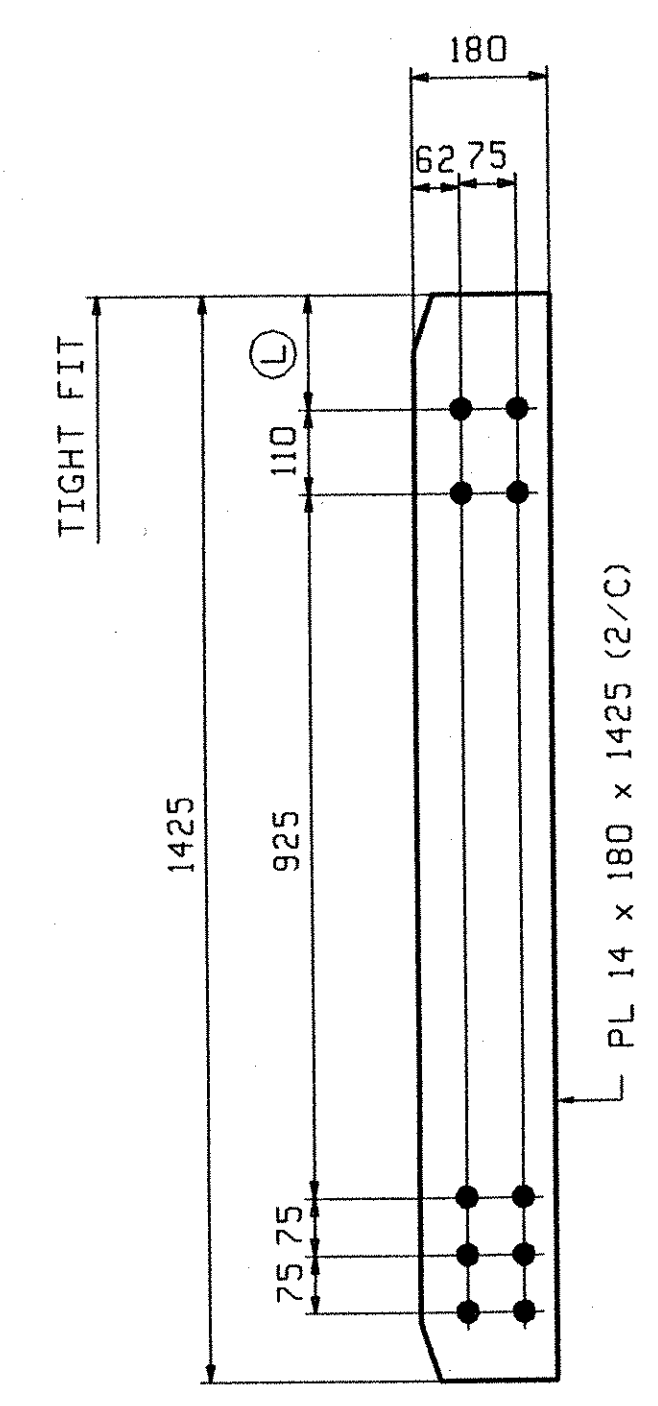


CROSSFR. CONN. STIFF

MARK	Q.TY	Ⓛ
x1c	20	150
x1d	10	107
x1f	10	87

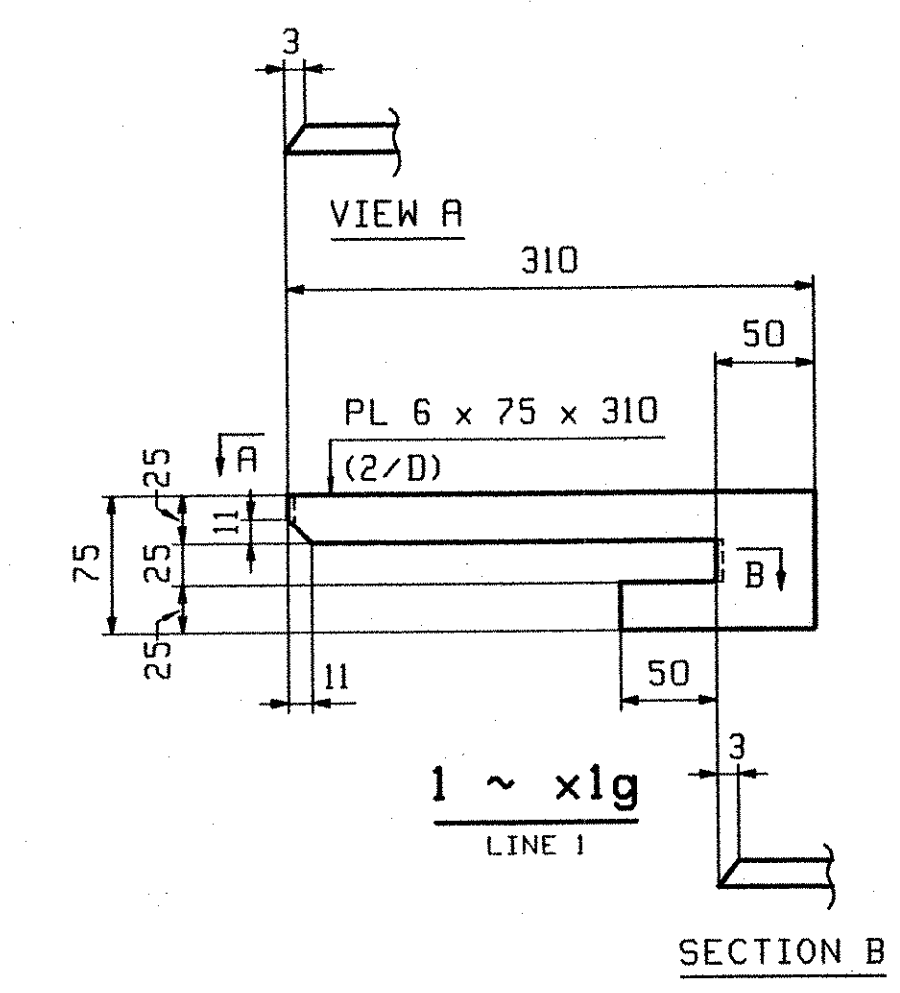

SECTION B

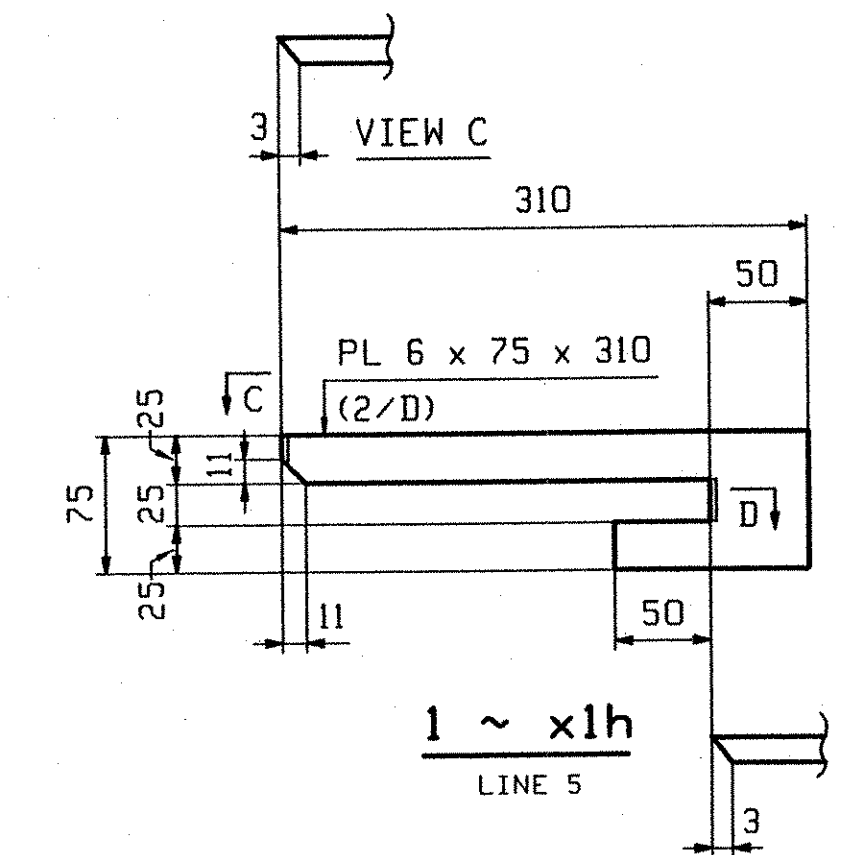

SECTION D

- NOTES:
1. ALL MATERIAL TO BE AASHTO M270M-345W.
 2. FOR GENERAL NOTES SEE DRAWING GNI.
 3. ALL BOLT HOLES SHALL BE $\frac{15}{16}$ " FOR $\frac{7}{8}$ " HSB.

OUT FOR APPROVAL	7-2-04										
ISSUED TO SHOP											
FIELD & OFFICE											
REV.	REMARKS	DATE	DWN	CHK	APP	Q.A.	NO.	DIA.	LGT	TYPE	WASHER
MATERIAL:	M270M-345W	ELECTRODES:		HOLES:	$\frac{15}{16}$ " (24mm)	SHOP BOLTS:					
SURFACE PREP. & PAINT: STEEL WITHIN 2450 OF ABUTMENT 2 SHALL BE PAINTED PER NOTES ON GNI. ALL OTHER STEEL SHALL BE UNPAINTED.											
DESCRIPTION:	GIRDER STANDARD										
JOB:	VT. ROUTE 118 OVER TROUT RIVER TOWN OF BERKSHIRE, VT FRANKLIN COUNTY										
PROJ NO.	BRF-RS 0283(?)										
CUSTOMER:	A.L. ST. ONGE										
CASCO BAY STEEL STRUCTURES, INC.	JOB NO.	DRG. NO.									
75 SPRING HILL ROAD PHONE (207) 282-7360	222	X1									
SACO, MAINE 04072 FAX. (207) 282-1179	15455	REV.									

Reviewed
 Rejected
 Furnish as Corrected
 Revise and Resubmit
 Submit Specified Item

This review is only for general conformance with the design concept and the information given in the Construction Documents. Corrections or comments made on the shop drawings during this review do not relieve the contractor from compliance with the requirements of the plans and specifications. Review of a specific item shall not include review of an assembly of which the item is a component. The Contractor is responsible for dimensions to be confirmed and corrected at the job site. Information that pertains solely to the fabrication process or to the means, methods, techniques, sequences and procedures of construction, coordination of the Work with that of all other trades are performing all work in a safe and satisfactory manner.

McFarland-Johnson, Inc.
 Date: 10/2/04
 By: Steven J. Dale

RECEIVED
 OCT 2 0 2004
 APPROVED
 DATE 11-01-04