



ONE - GIRDER - 2G2A
 FOR GIRDER STANDARD DETAILS SEE DRAWING X1.
 FOR CAMBER DIAGRAM SEE DRAWING C1.
 FOR GENERAL NOTES SEE DRAWING GNI.
 H2-3 DENOTES MATERIAL SUBJECT TO CHARPY V-NOTCH TESTING.

ABM INFO		SHIP	BILL OF MATERIAL				JOB NO.	DRAWING NO.	REV.
PAGE	LINE	MARK	QTY	MARK	MATERIAL	LENGTH	REMARKS	WT	PROCUREMENT NOTES
						m			
		2G2A	1		GIRDER			1556 kg 3649 lb	
1	G		1	wa	PL 16x1425	23 084	(H270M-345HT2)	(H2-3)	
1	J		1	wb	PL 16x1425	21 396	(H270M-345HT2)	(H2-3)	
1	N		1	ta	PL 22x400	21 336			
1	L		1	tb	PL 22x400	23 123			
1	E		1	ba	PL 22x450	9 460	(H270M-345HT2)	(H2-3)	
1	A		1	bb	PL 40x450	25 500	(H270M-345HT2)	(H2-3)	
1	C		1	bc	PL 22x450	9 434	(H270M-345HT2)	(H2-3)	
2	B		4	x1a	PL 20x190	1 425			
2	C		5	x1c	PL 14x180	1 425			
2	C		5	x1d	PL 14x180	1 425			

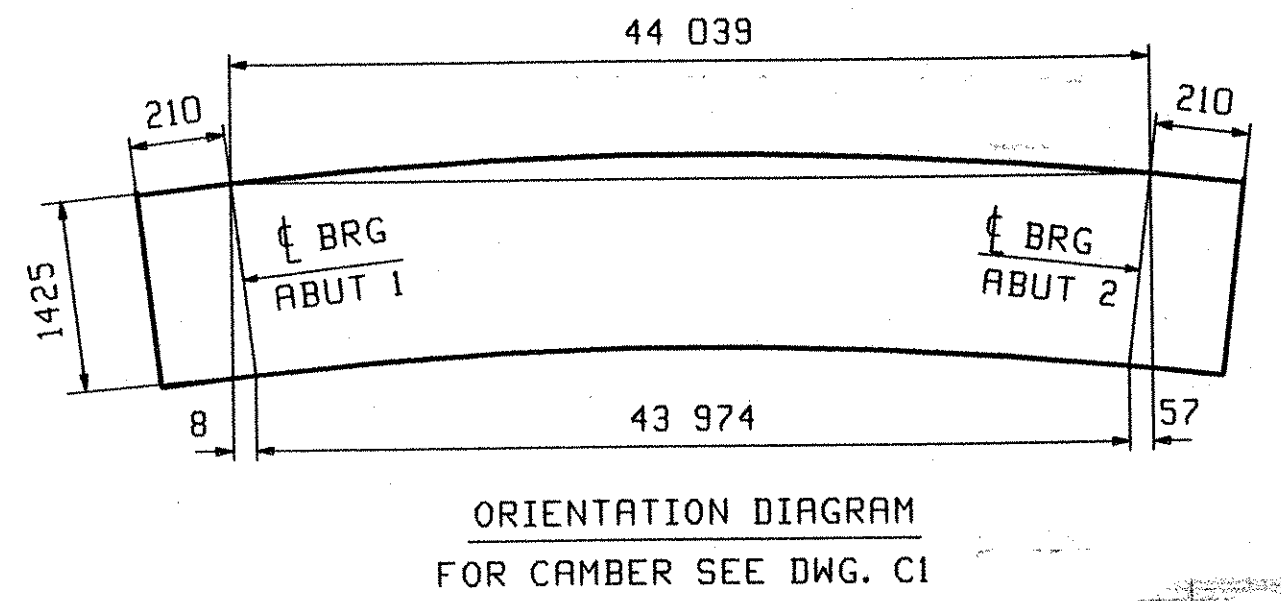

ORIENTATION DIAGRAM
 FOR CAMBER SEE DWG. C1

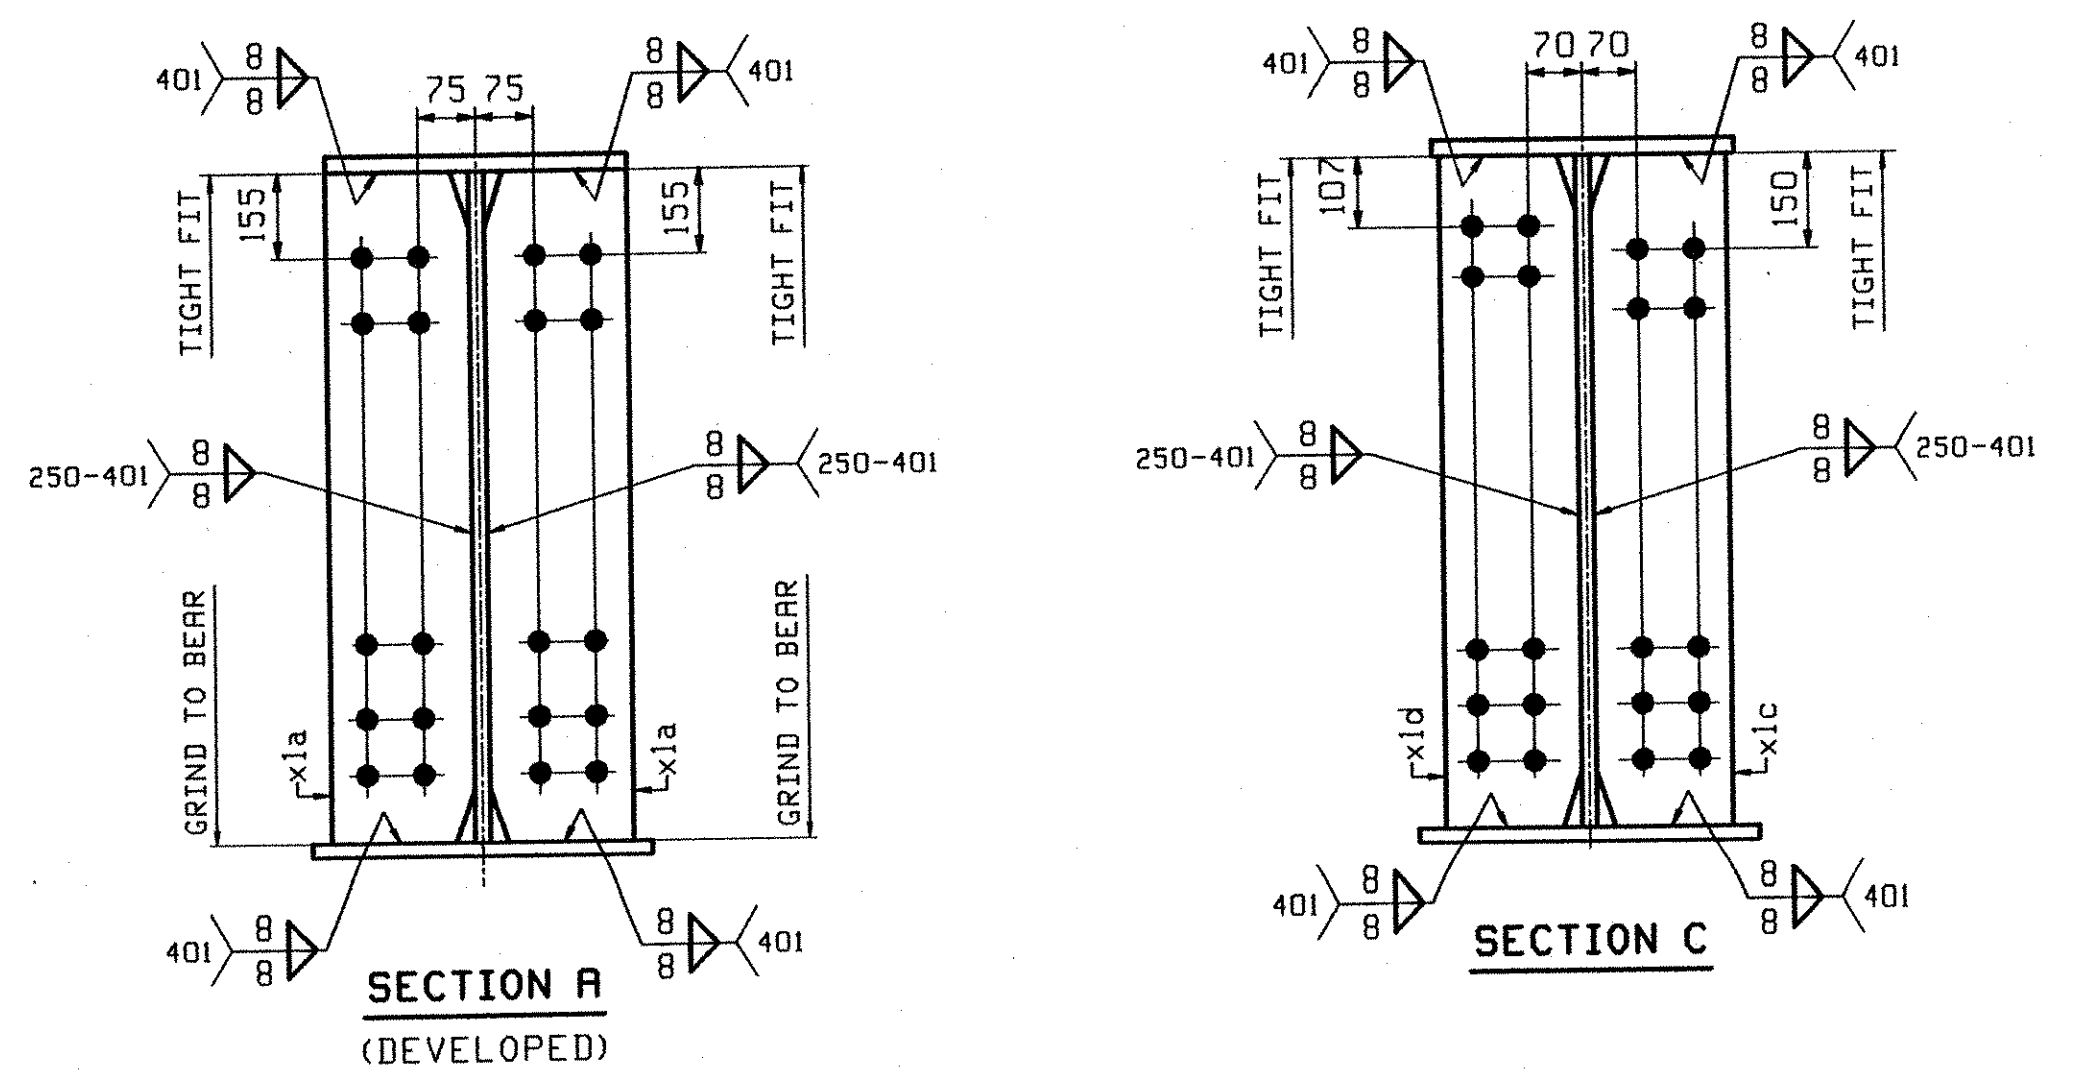

Reviewed
 Rejected
 Furnish as Corrected
 Revise and Resubmit
 Submit Specified Item

This review is only for general conformance with the design concept and the information given in the Construction Documents. Corrections or comments made on the shop drawings during this review do not relieve the contractor from compliance with the requirements of the plans and specifications. Review of a specific item shall not constitute review of an assembly of which the item is a component. The Contractor is responsible for dimensions to be confirmed and coordinated at the job site; information that pertains to the fabrication process or to the means, methods, sequences, and procedures of construction; coordination of the work with that of all other trades; and performing all work in a safe and satisfactory manner.

McFarland-Johnson, Inc.
 RECEIVED
 OCT 20 2004
 RESUBMIT APPROVED
 BY DATE 11-01-04

OUT FOR APPROVAL	9-2-04										
OUT FOR APPROVAL											
ISSUED TO SHOP											
FIELD & OFFICE											
REV.	REMARKS	DATE	DWN	CHK	APP	O.A.	NO.	DIA.	LGT	TYPE	WASHER
MATERIAL:	ELECTRODES:	HOLES:	SHOP BOLTS:								
M270M-345W		15 16" (24mm) (UN)									
SURFACE PREP. & PAINT: STEEL WITHIN 2450 OF ABUTMENT 2 SHALL BE PAINTED PER NOTES ON GNI. ALL OTHER STEEL SHALL BE UNPAINTED.											
DESCRIPTION:	GIRDER - 2G2A					DRAWN BY	DATE				
JOB:	VT. ROUTE 118 OVER TROUT RIVER					AB	07/27/04				
	TOWN OF BERKSHIRE, VT					CHKD BY					
	FRANKLIN COUNTY					PCP	07/30/04				
						APPROV BY					
						SUPERVISOR	H. J. GATTI				
PROJ NO.	BRF-RS 0283(7)					O.A.					
CUSTOMER:	A.L. ST. ONGE					JOB NO.	DRG. NO.				
						222	2				
75 SPRING HILL ROAD	SARCO, MAINE 04072		PHONE (207) 282-7360		FAX. (207) 282-1179	156 SS	REV.	▲			