


**EXCAVATIONS & REMOVALS**  
(NOT TO SCALE)

IF THE ENGINEER DETERMINES THAT THE CONCRETE OF AN EXISTING ABUTMENT IS SOUND, THE ABUTMENT MAY BE CUT AT THE TOP OF THE STONE FILL LINE AND LEFT IN PLACE INSTEAD OF STONE FILL. OTHERWISE CUT THE ABUTMENT TO THE INDICATED ELEVATIONS.

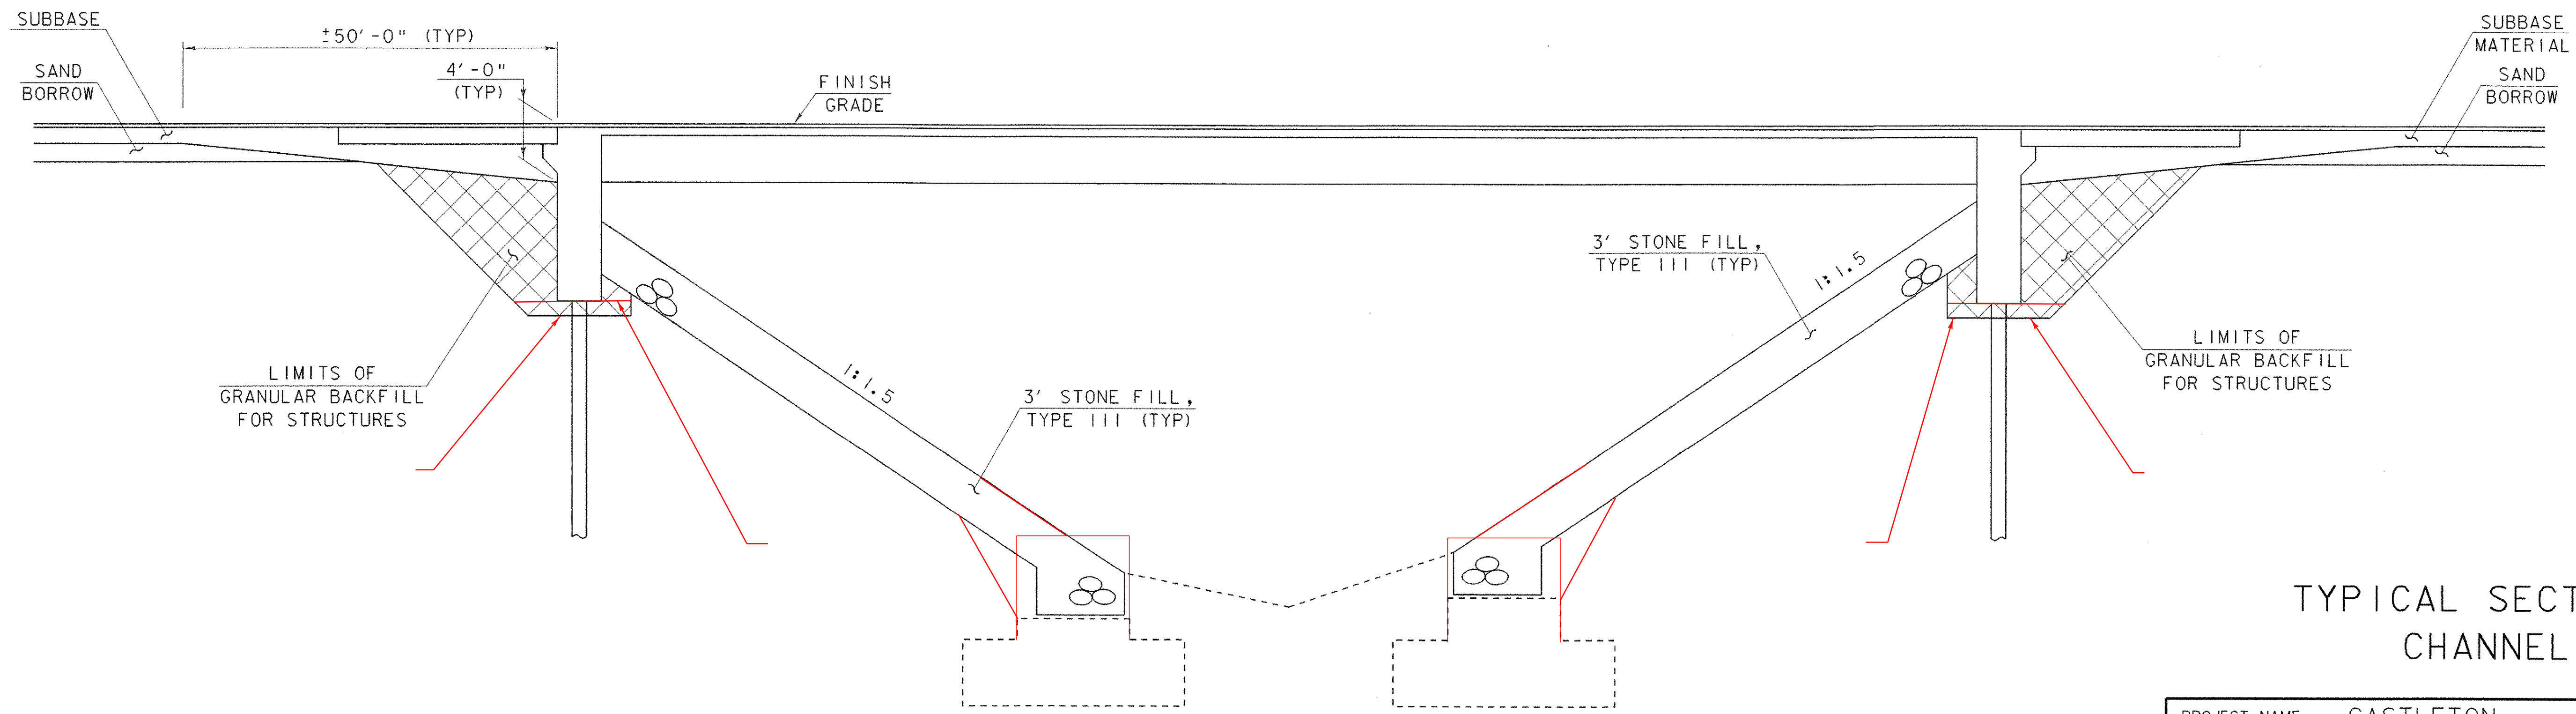

**FILLS**  
(NOT TO SCALE)

**TYPICAL SECTIONS CHANNEL**

PROJECT NAME: CASTLETON	
PROJECT NUMBER: RS 0142(10)	
FILE NAME: sf193tx2.i	PLOT DATE: 09-FEB-2007
PROJECT LEADER: R. WHITCOMB	DRAWN BY: T. LACKEY
DESIGNED BY: T. LACKEY	CHECKED BY: R. WHITCOMB
T8F193/str/sf193xsl.dgn	SHEET 4 OF 68