


SURVEY PLAN I

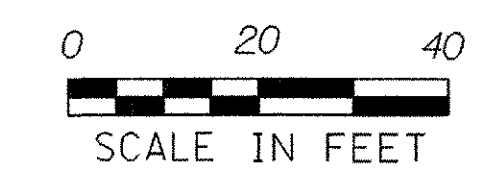

PROJECT NAME: CASTLETON	PLOT DATE: 09-FEB-2007
PROJECT NUMBER: RS 0142(10)	DRAWN BY: T. LACKEY
FILE NAME: sf193sul1	CHECKED BY: W. LAMMER
PROJECT LEADER: R. WHITCOMB	SHEET 12 OF 68
DESIGNED BY: T. LACKEY	
78f193/str/sf193sur.dgn	