


PROFILE 2

SUPERELEVATION

PROFILE MAINLINE

NOTE:
 ELEVATIONS SHOWN TO THE NEAREST TENTH ARE
 OLD GROUND ALONG THE PROPOSED ALIGNMENT.
 ELEVATIONS SHOWN TO THE NEAREST HUNDREDTH ARE
 FINISHED GRADES ALONG THE PROPOSED ALIGNMENT.

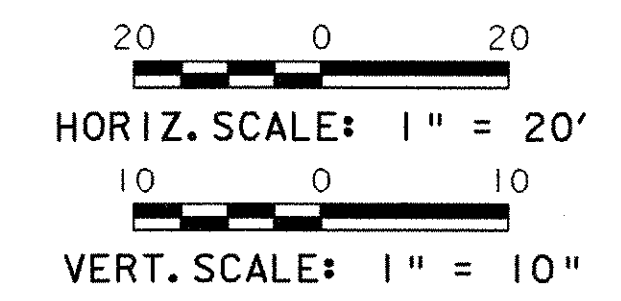

PROJECT NAME:	CASTLETON	PLOT DATE:	09-FEB-2007
PROJECT NUMBER:	RS 0142(10)	DRAWN BY:	T. LACKEY
FILE NAME:	sf193pfl	CHECKED BY:	R. WHITCOMB
PROJECT LEADER:	R. WHITCOMB	SHEET	17 OF 68
DESIGNED BY:	T. LACKEY		
78f193/structures/sf193xsl.dgn			