


NOTES:

1. SEE SECTIONS TO DETERMINE CUT OR FILL.
2. SEE TYPICAL SECTIONS CHANNEL SHEET FOR ABUTMENT EARTHWORK DETAILS.

MATERIAL TRANSITION DETAIL

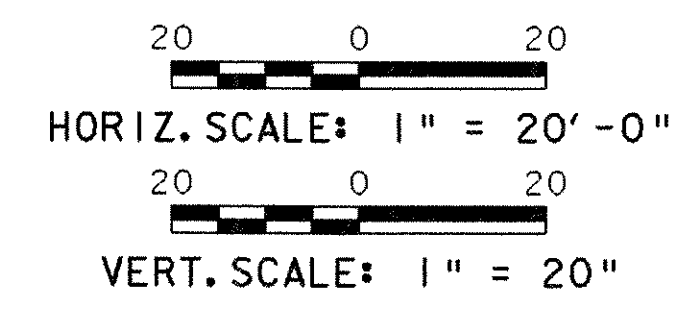

PROFILE
 MAINLINE
 MATERIAL TRANSITION DETAIL

PROJECT NAME: CASTLETON	PLOT DATE: 09-FEB-2007
PROJECT NUMBER: RS 0142(10)	DRAWN BY: T. LACKEY
FILE NAME: sf193pf3.1	CHECKED BY: R. WHITCOMB
PROJECT LEADER: R. WHITCOMB	SHEET 19 OF 68
DESIGNED BY: T. LACKEY	
78f193/structures/sf193xsl.dgn	