

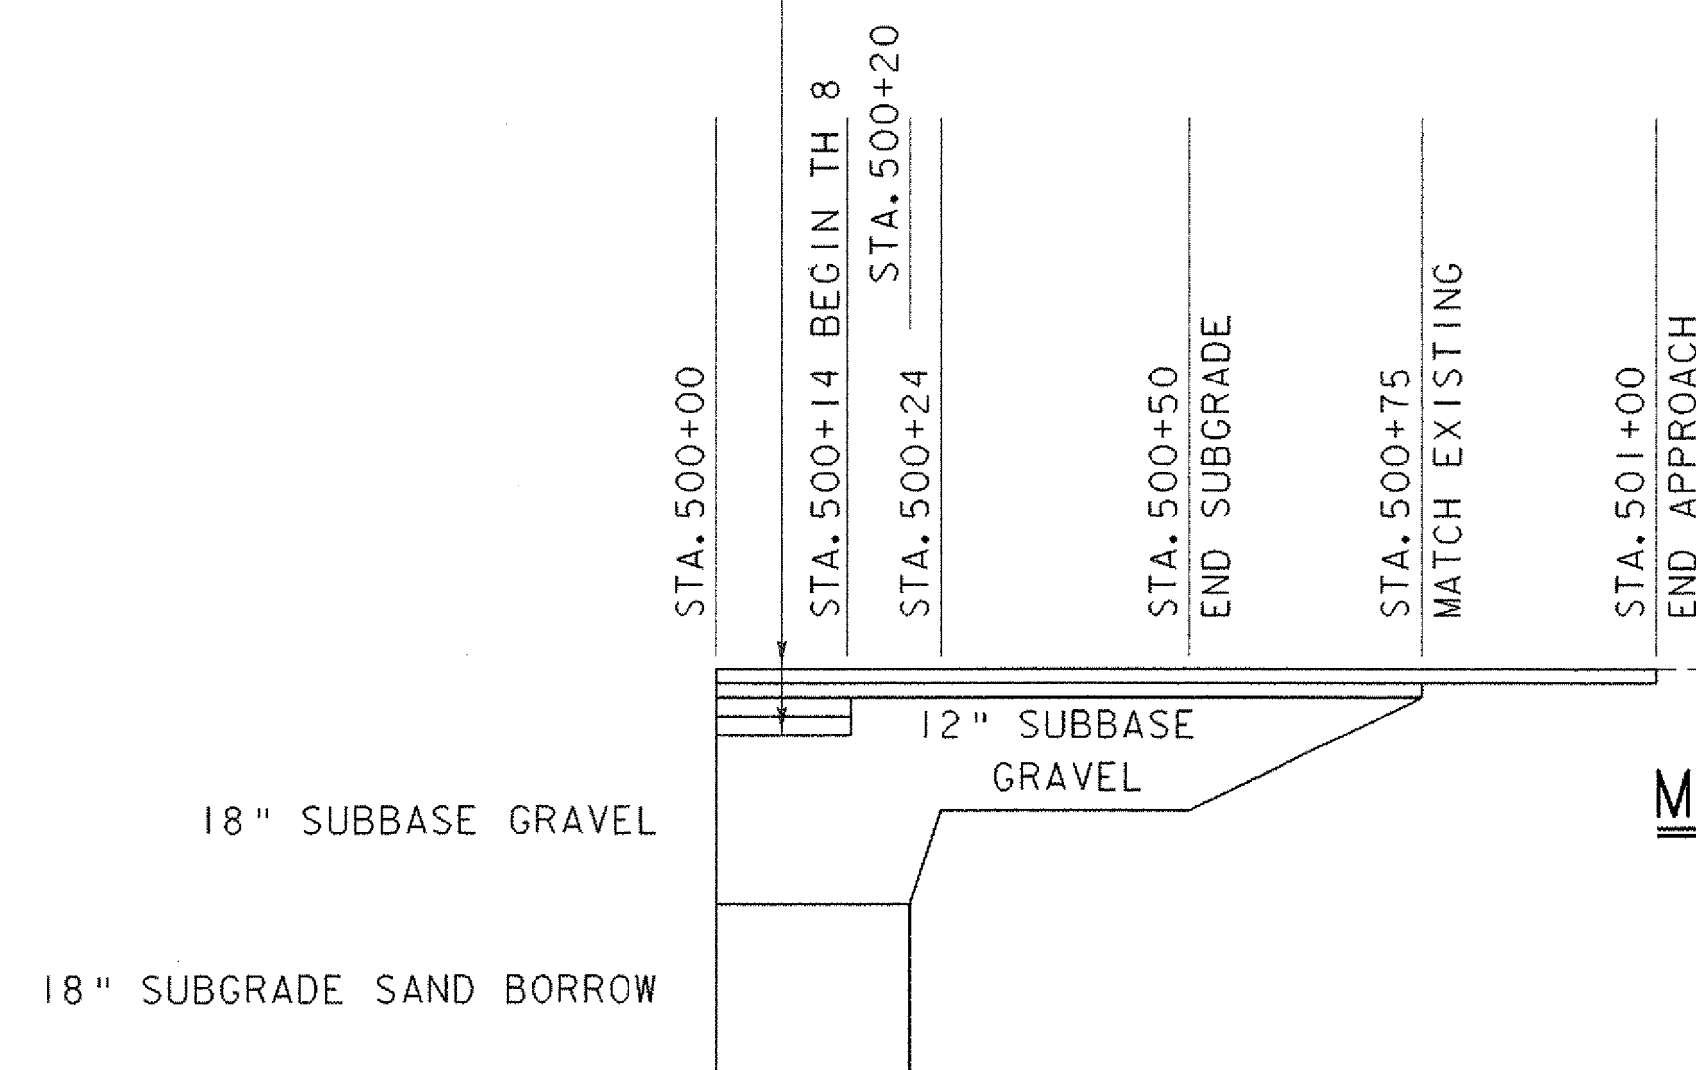



- 1 1/2" WEARING SURFACE COURSE (2ND LIFT) BCP TYPE III (TYP.)
- 1 1/2" WEARING SURFACE COURSE (1ST LIFT) BCP TYPE III (TYP.)
- 2" BASE COURSE (2ND LIFT) BCP TYPE I OR II (TYP.)
- 2" BASE COURSE (1ST LIFT) BCP TYPE I OR II (TYP.)

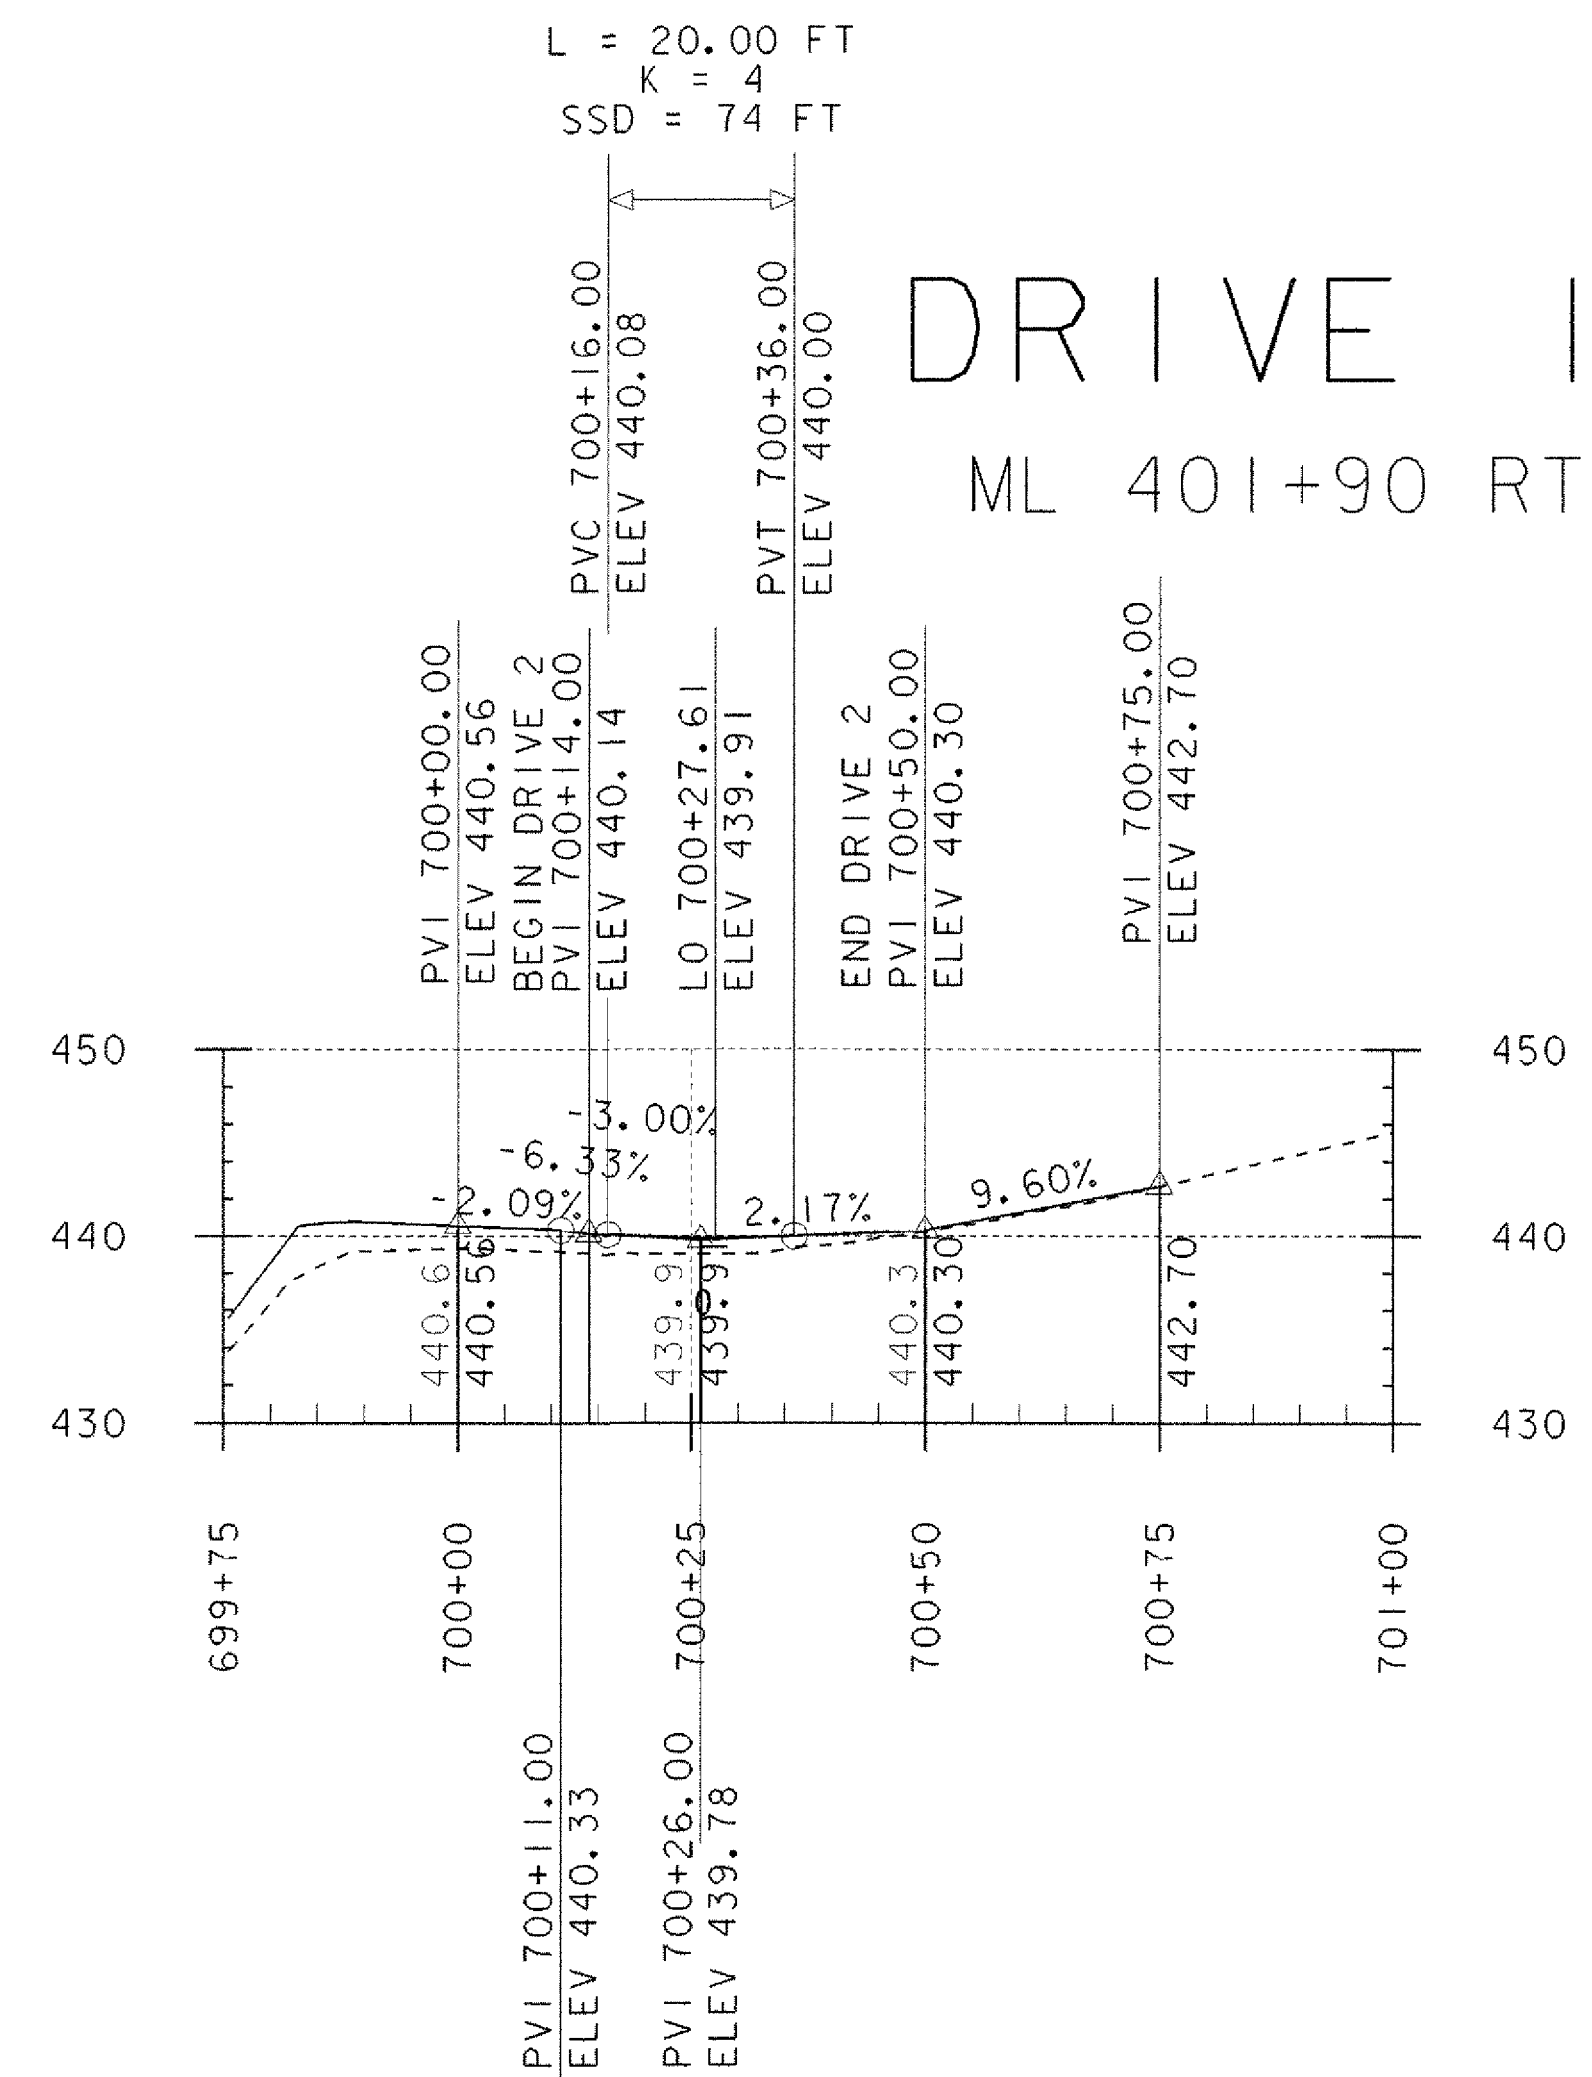

**MATERIAL TRANSITION DETAIL**

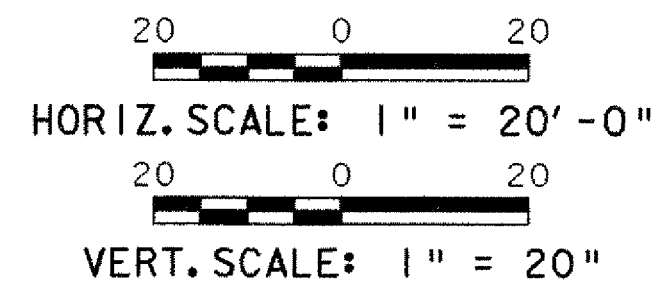

**DRIVE I CULVERT**  
DRI PC 700+27.84

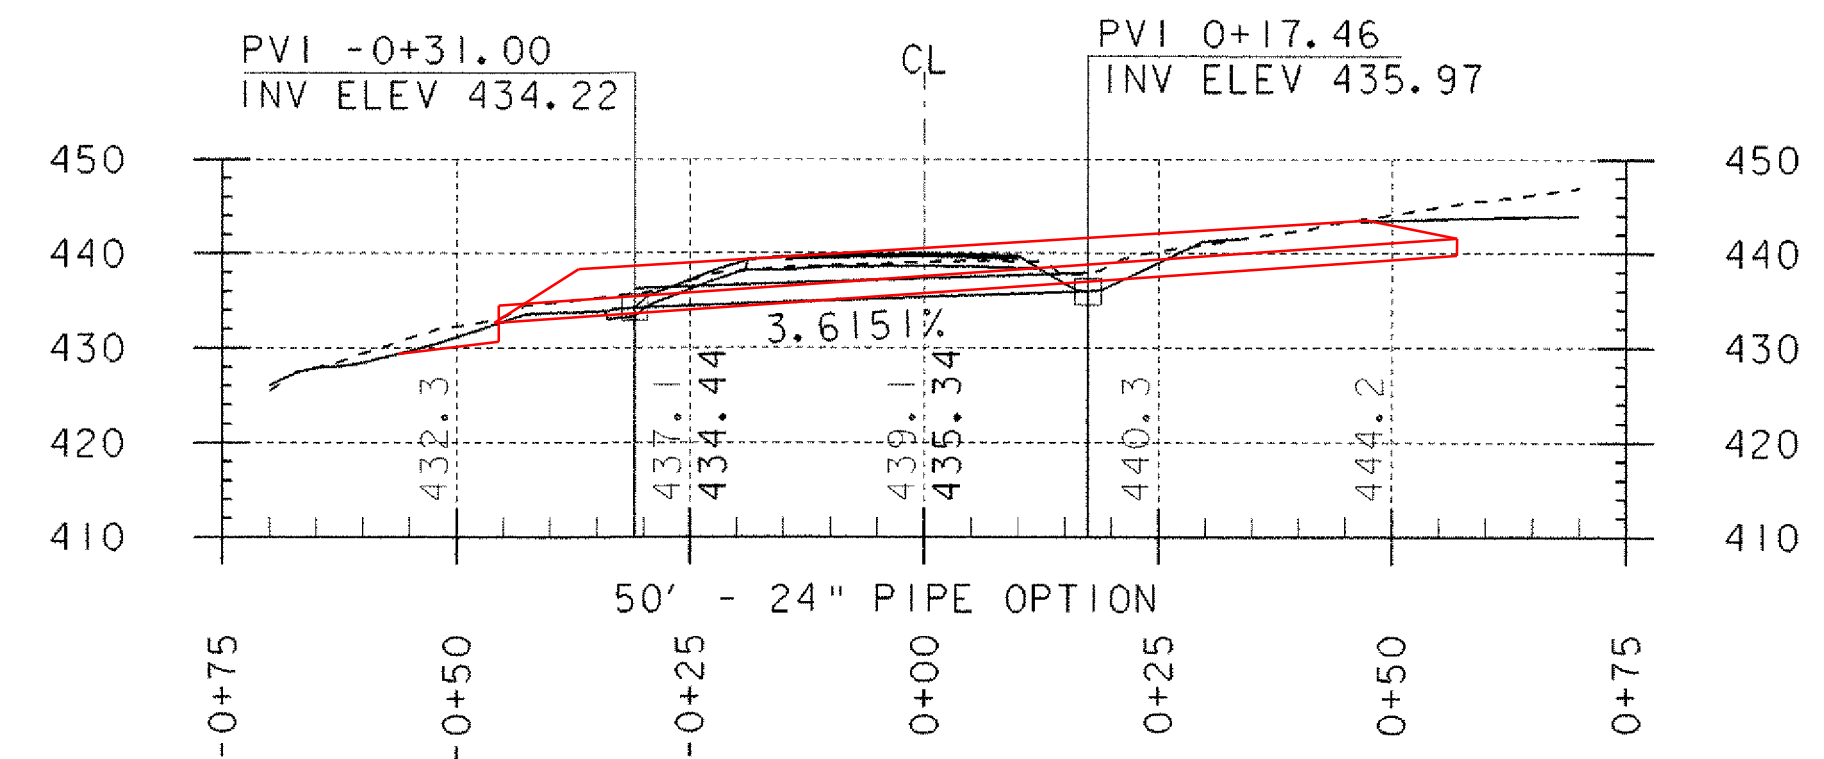

**PROFILE TH 8 & DRIVE**

NOTE:  
ELEVATIONS SHOWN TO THE NEAREST TENTH ARE OLD GROUND ALONG THE PROPOSED ALIGNMENT.  
ELEVATIONS SHOWN TO THE NEAREST HUNDREDTH ARE FINISHED GRADES ALONG THE PROPOSED ALIGNMENT.

PROJECT NAME: CASTLETON	PLOT DATE: 09-FEB-2007
PROJECT NUMBER: RS 0142(10)	DRAWN BY: T. LACKEY
FILE NAME: sf193p.f4.1	CHECKED BY: R. WHITCOMB
PROJECT LEADER: R. WHITCOMB	SHEET 20 OF 68
DESIGNED BY: T. LACKEY	
78f193/structures/sf193xsl.dgn	