


UTILITIES
PLAN I

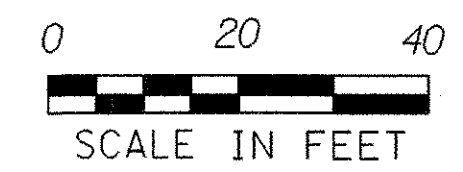

PROJECT NAME: CASTLETON	PLOT DATE: 09-FEB-2007
PROJECT NUMBER: RS 0142(10)	DRAWN BY: T. LACKEY
FILE NAME: sf193uti.i	CHECKED BY: T. GILMAN
PROJECT LEADER: R. WHITCOMB	SHEET 21 OF 68
DESIGNED BY: T. LACKEY	
78f193/str/sf193uti.dgn	