

Urban Soil
unknown erodability

110
Limerick Silt Loam
kw = 0.49
high erodability


110
Limerick Silt Loam
kw = 0.49
high erodability

110
Limerick Silt Loam
kw = 0.49
high erodability

149E
Bomoseen & Pittstown, Very Stony
kw = 0.20
low erodability

IMPACT AREAS

RESOURCE	TEMPORARY	PERMANENT
OHW	5 sf	305 sf
WETLANDS	0 sf	90 sf

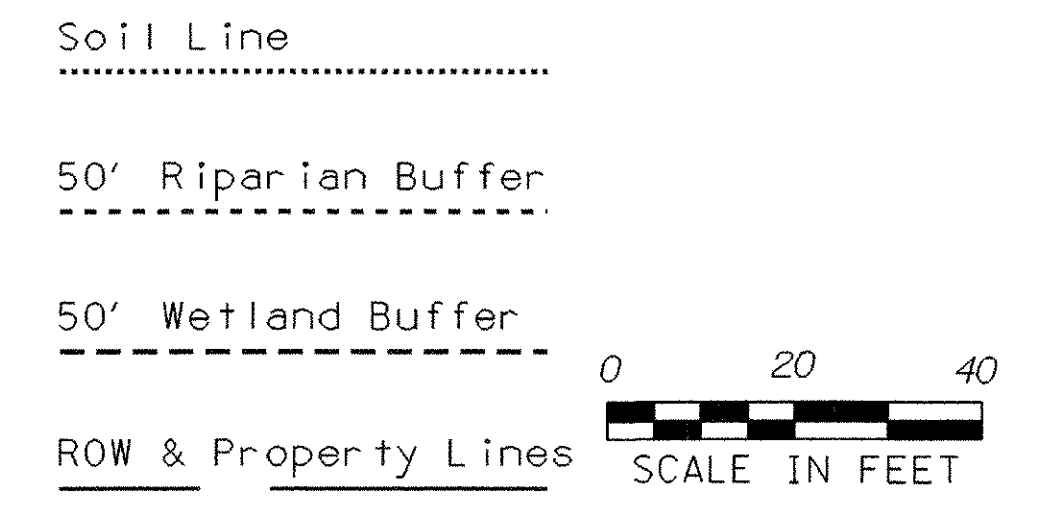

RESOURCE PLAN

PROJECT NAME:	CASTLETON	PLOT DATE:	09-FEB-2007
PROJECT NUMBER:	RS 0142(10)	DRAWN BY:	T. LACKEY
FILE NAME:	sf193rsc.d	DESIGNED BY:	T. LACKEY
		CHECKED BY:	W. LAMMER
			SHEET 23 OF 68