


PLAN
SCALE 1" = 10'-0"

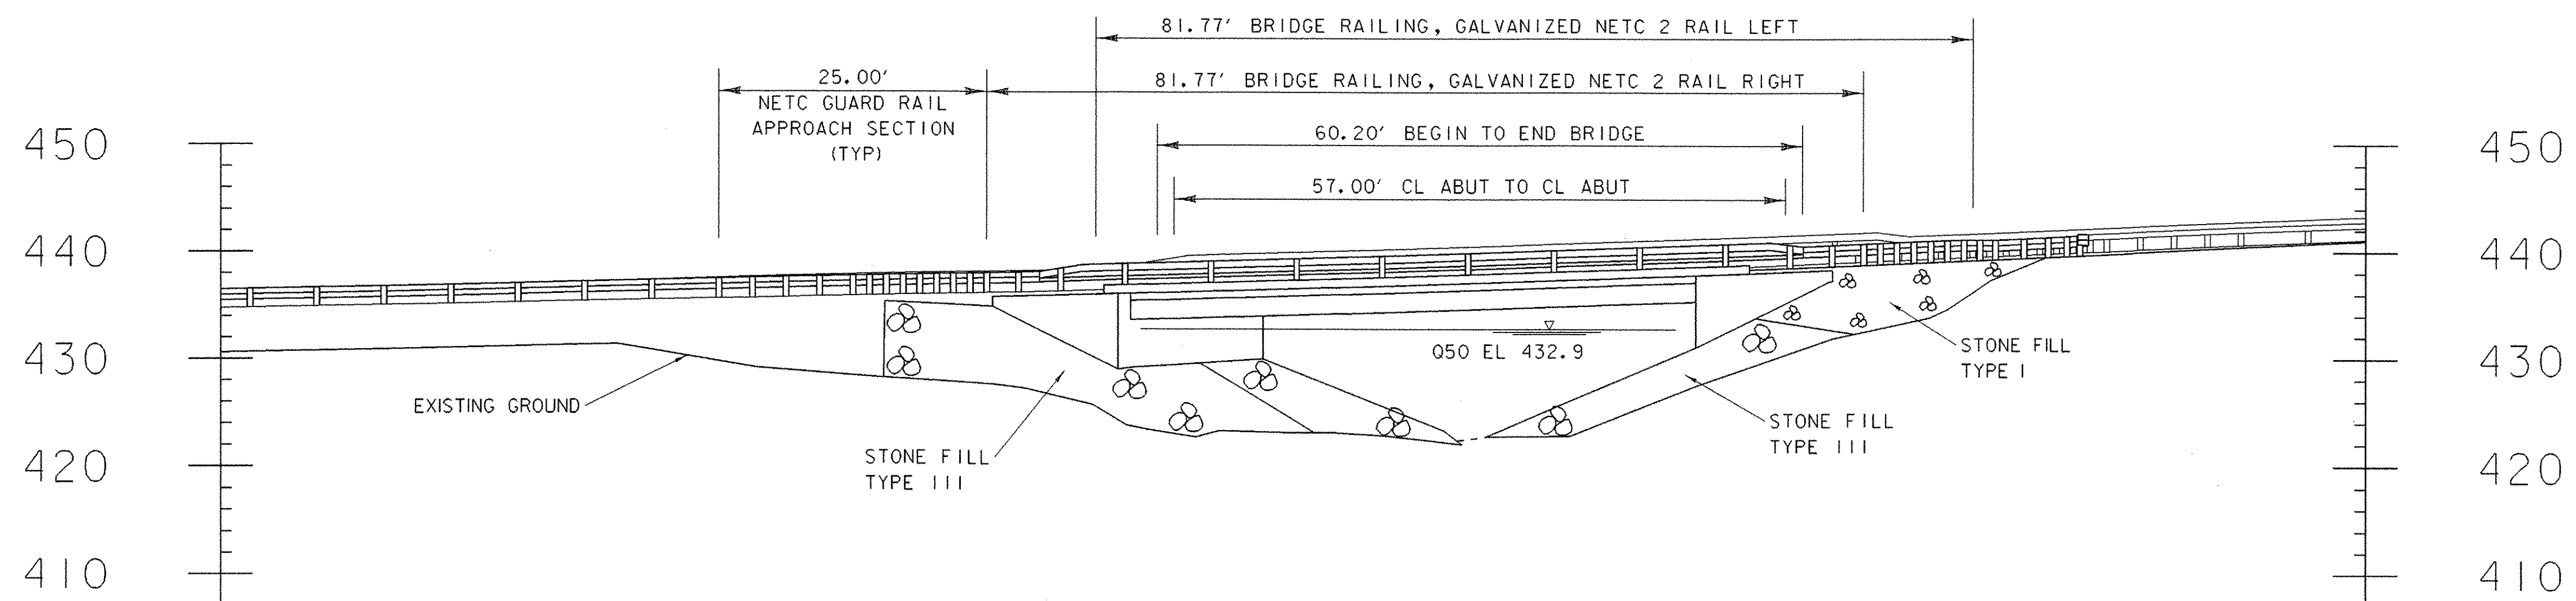

ELEVATION
SCALE 1" = 10'-0"

PLAN & ELEVATION

PROJECT NAME: CASTLETON	PLOT DATE: 09-FEB-2007
PROJECT NUMBER: RS 0142(10)	DRAWN BY: T. LACKEY
FILE NAME: sf193pe.i	CHECKED BY: R. WHITCOMB
PROJECT LEADER: R. WHITCOMB	SHEET 39 OF 68
DESIGNED BY: T. LACKEY	
78f193/str/sf193pe.dgn	