


TYPICAL SECTION AT MIDSPAN


SCALE 1/2" = 1'-0"  
1 0 1 2

\* TWO LIFTS: 1 1/2" BITUMINOUS CONCRETE PAVEMENT, TYPE III

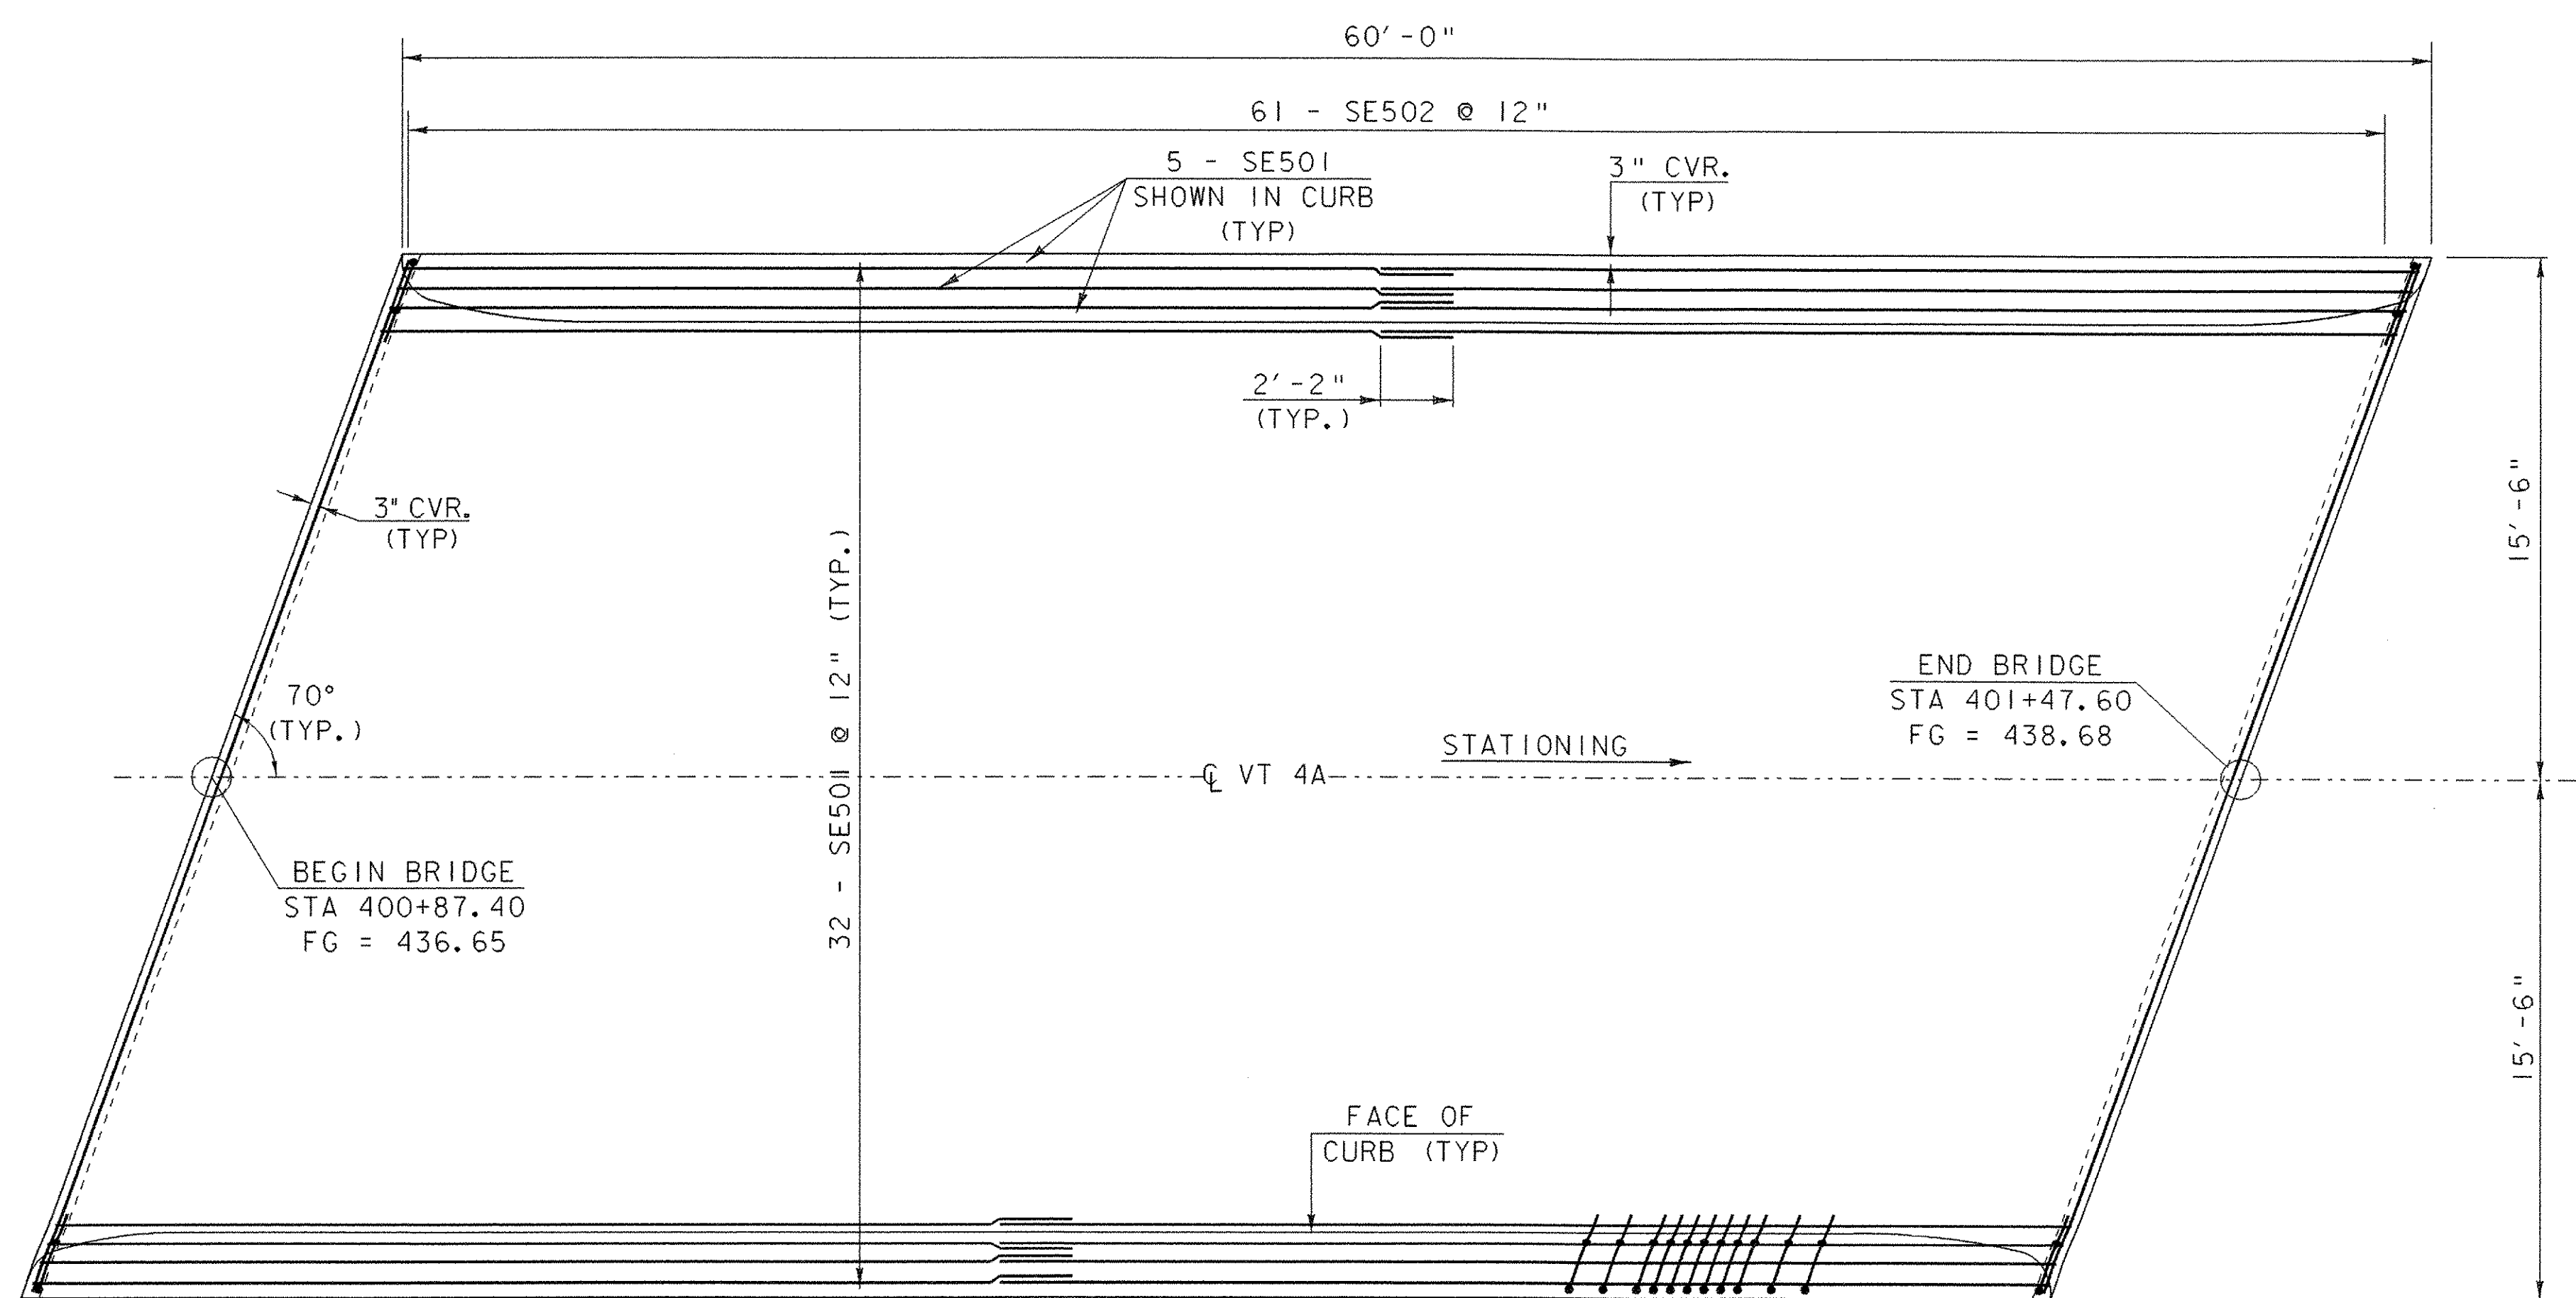


DECK OVERLAY REINFORCING

SCALE 1/4" = 1'-0"  
1 0 2 4 6

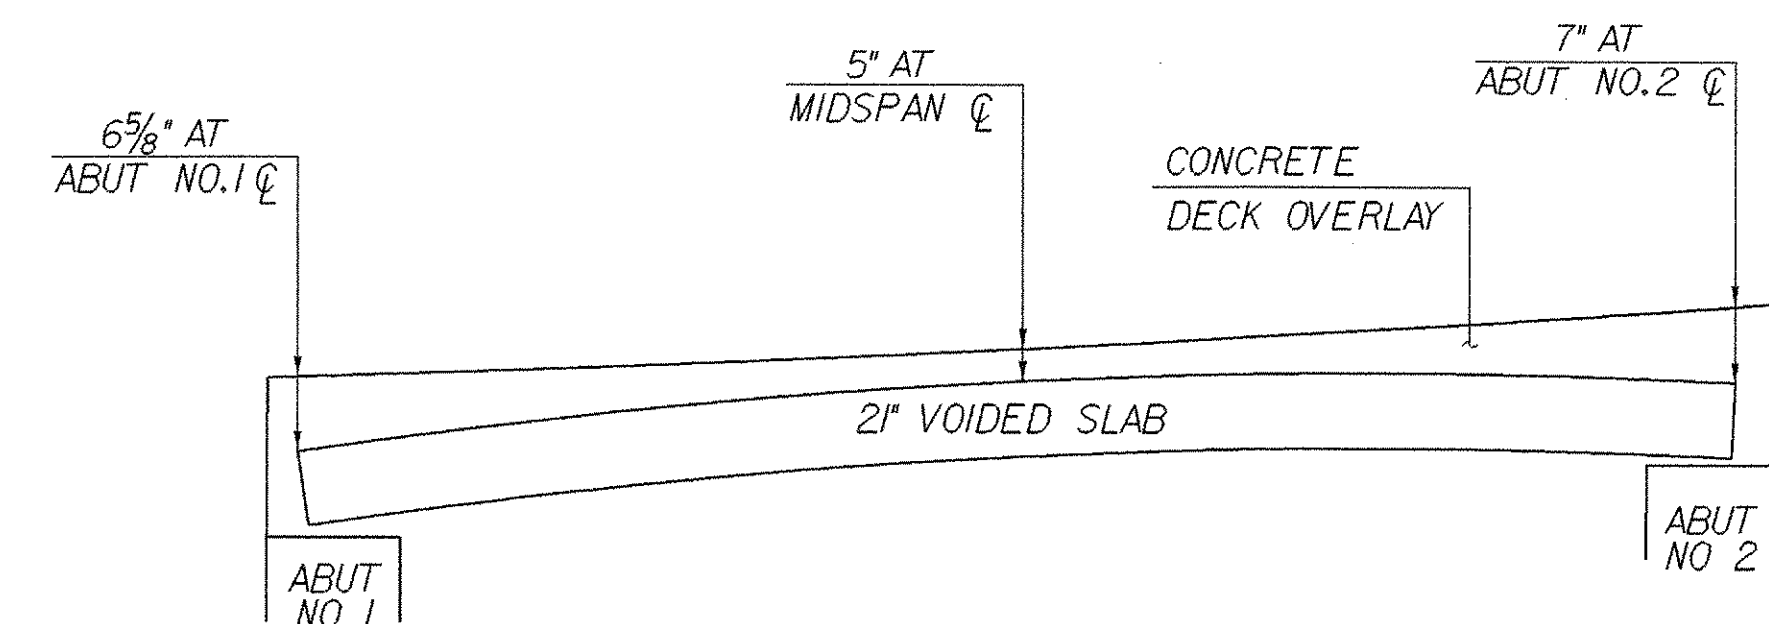

DECK OVERLAY DETAIL

NTS

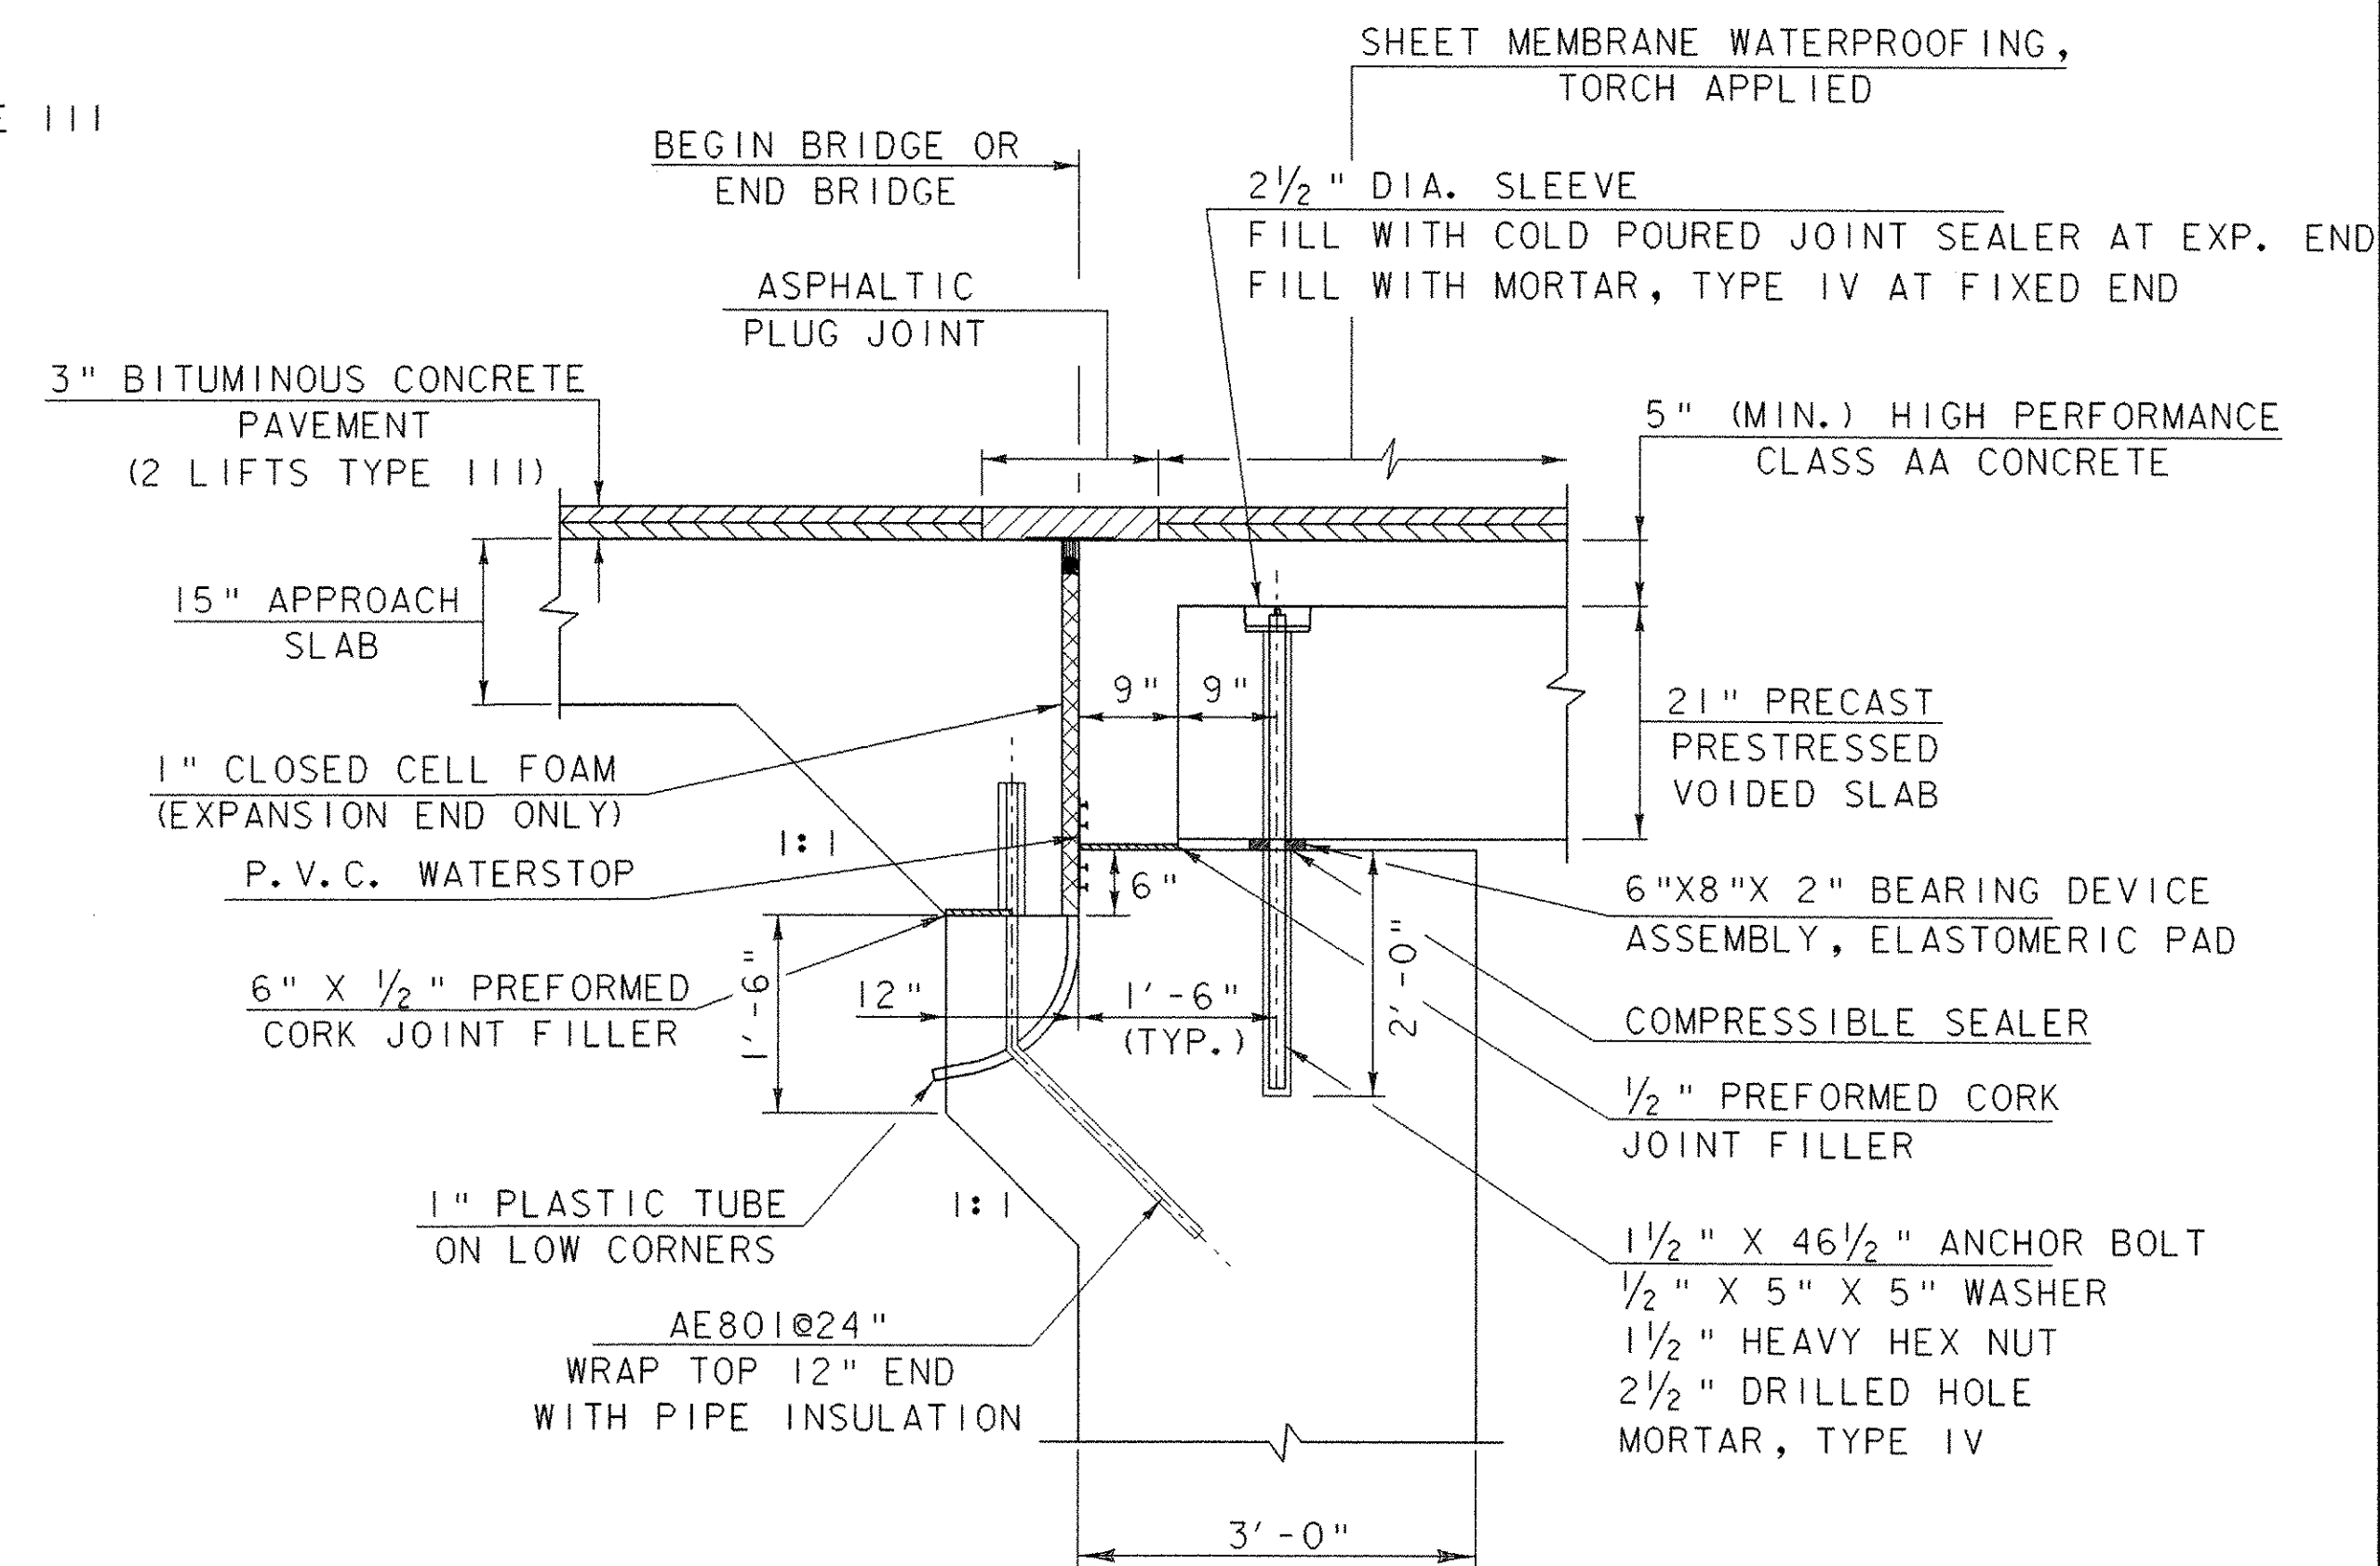

BRIDGE END DETAIL @ ABUTMENTS  
(NORMAL TO CL BEARING)

SCALE 3/4" = 1'-0"  
1 0 1 2

SUPERSTRUCTURE DETAILS  
TYPICAL SECTION &  
DECK OVERLAY REINFORCING

PROJECT NAME: CASTLETON	PLOT DATE: 16-FEB-2007
PROJECT NUMBER: RS 0142(10)	DRAWN BY: L. BULLOCK
FILE NAME: PW/78f193/sf193sup.dgn	CHECKED BY: C. CARLSON
PROJECT LEADER: R. WHITCOMB	SHEET 46 OF 68
DESIGNED BY: M. HALE	
78f193/str/sf193typ.1	