



ABUTMENT NO. 1 PLAN

SCALE 3/8" = 1'-0"
 1 0 1 2 3 4

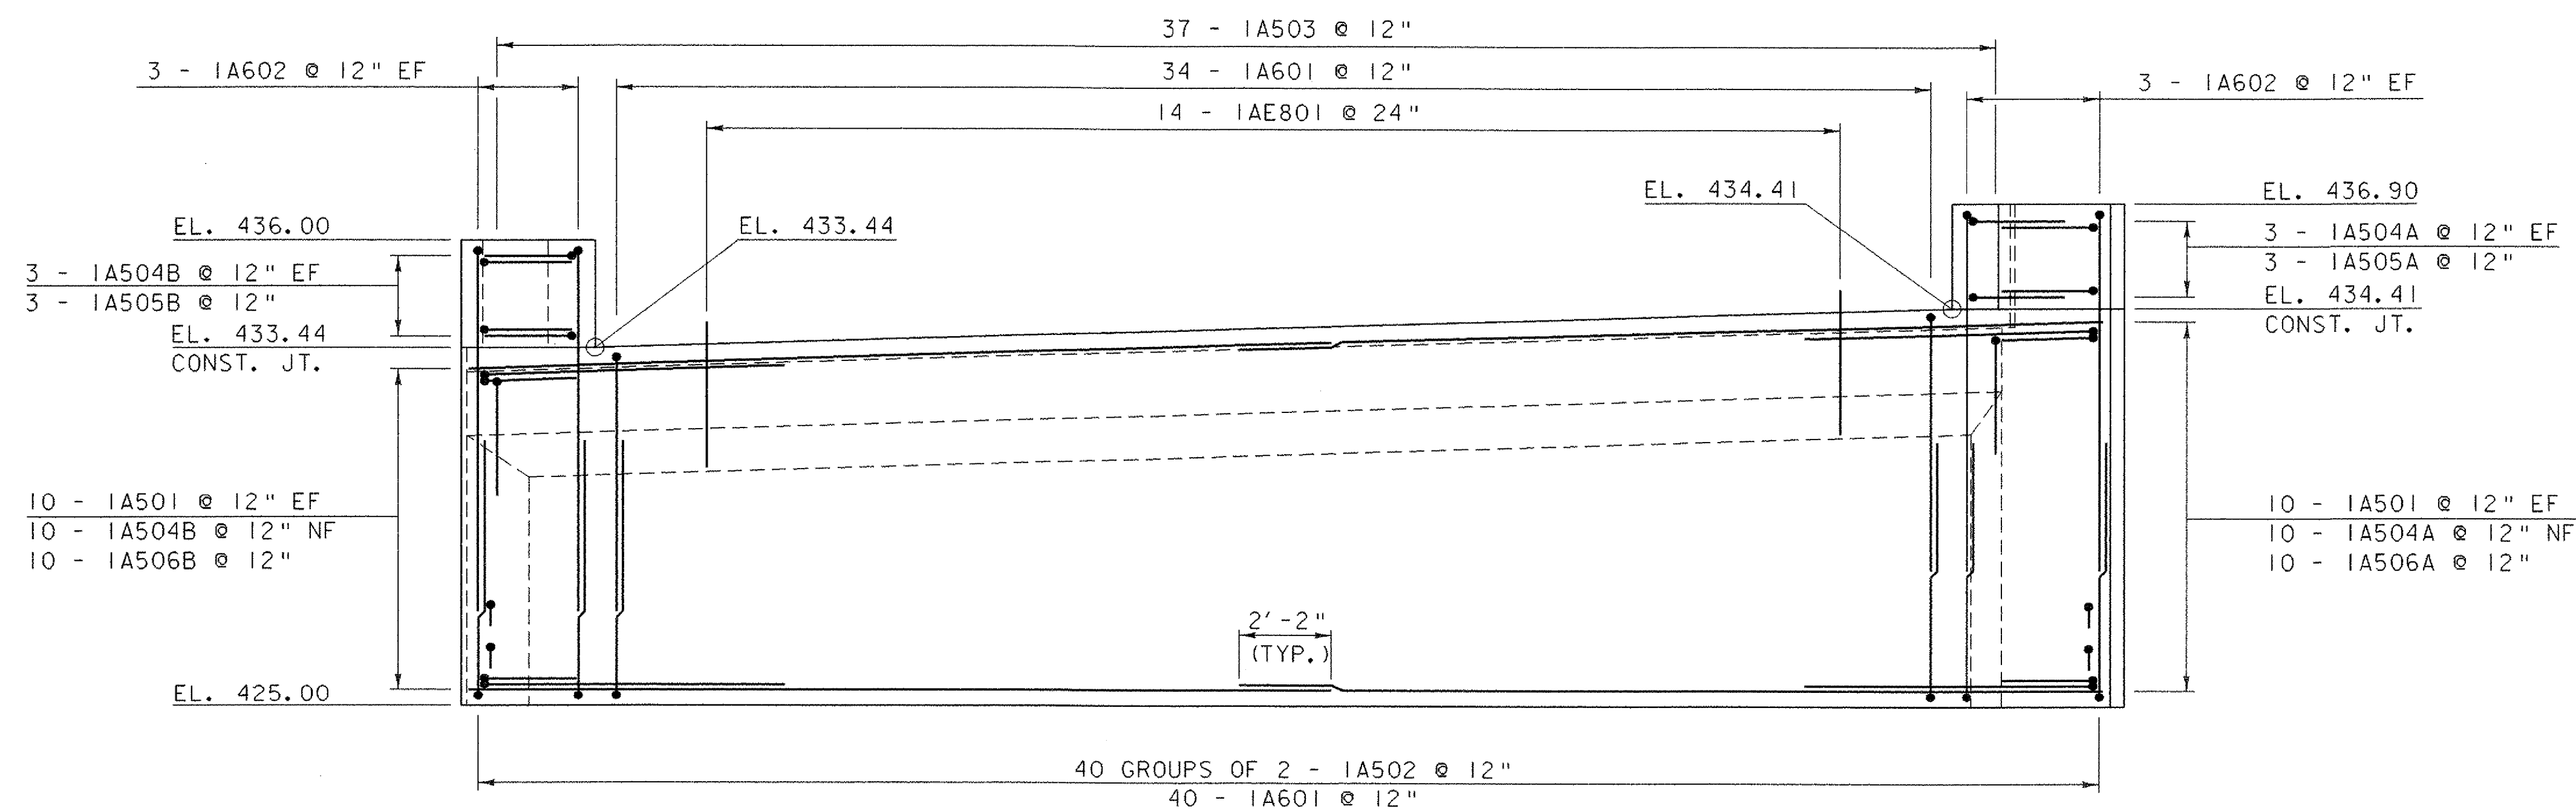

ABUTMENT NO. 1 ELEVATION

SCALE 3/8" = 1'-0"
 1 0 1 2 3 4

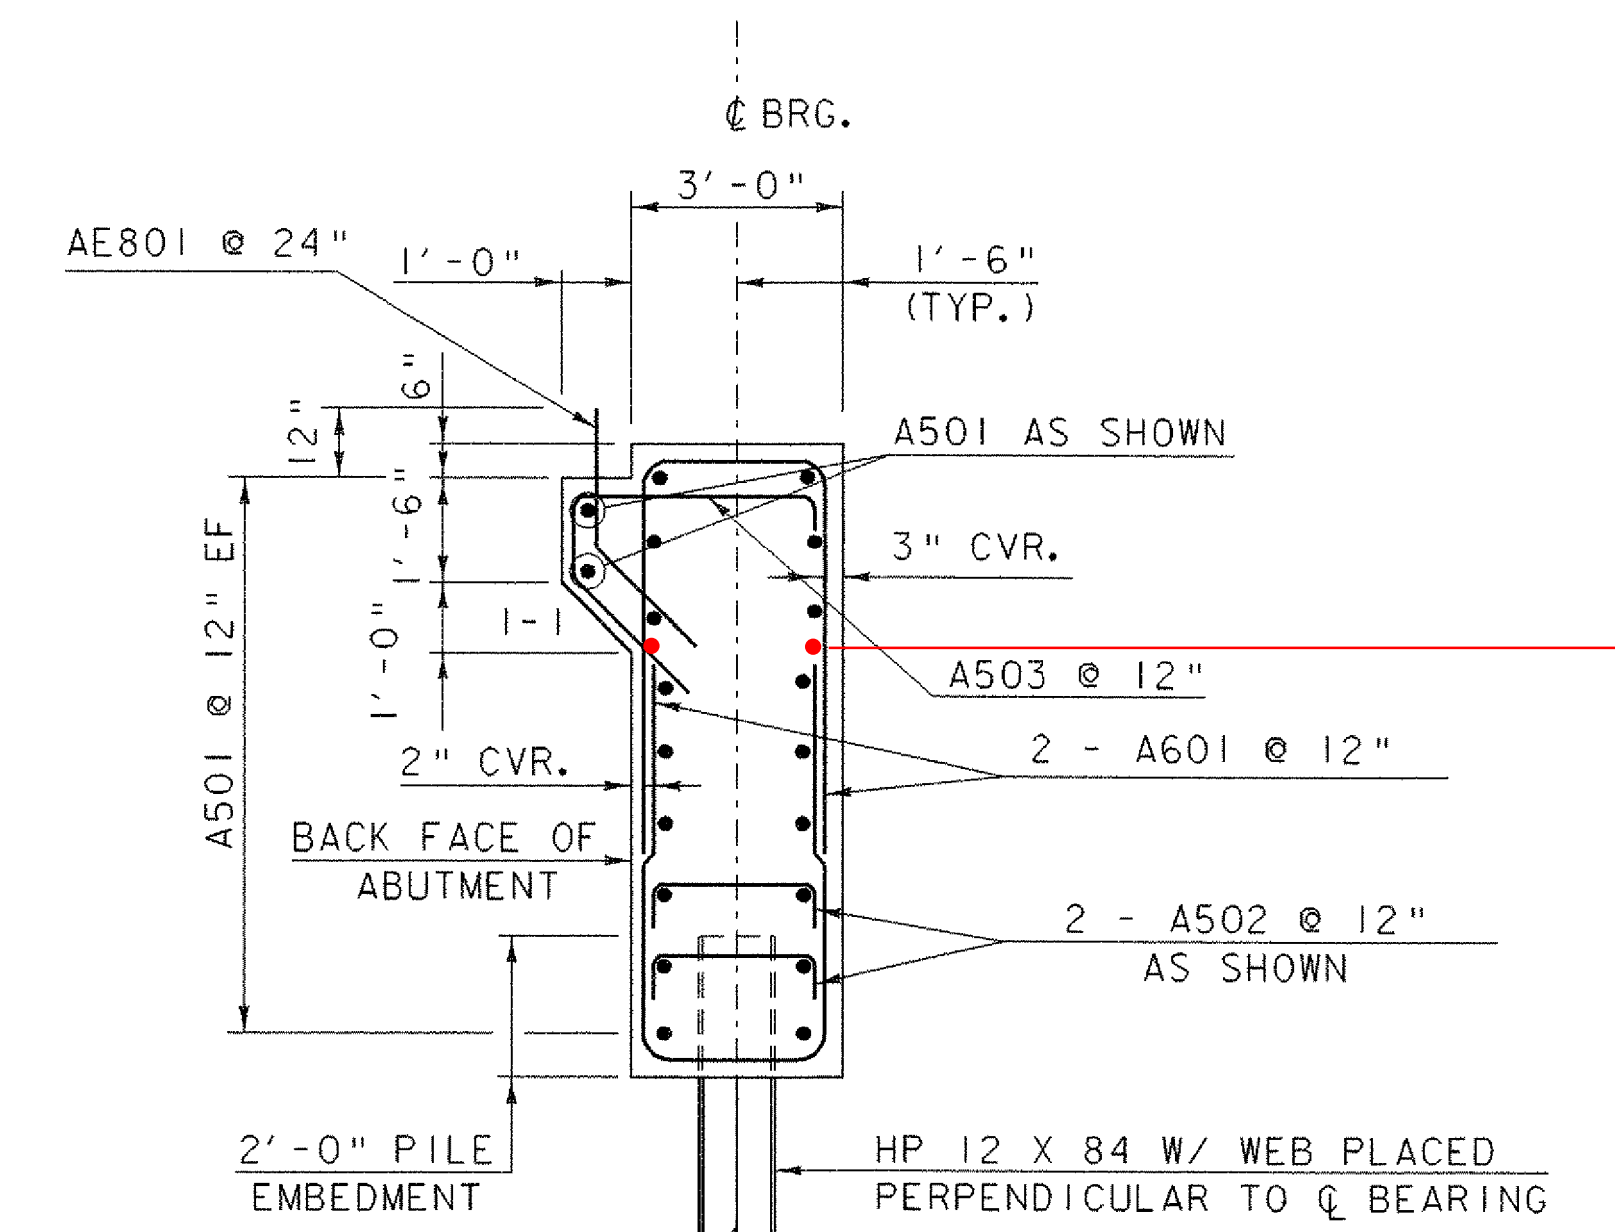

ABUTMENT TYPICAL

SCALE 3/8" = 1'-0"
 1 0 1 2 3 4

NOTE:

- NF = NEAR FACE
- FF = FAR FACE
- EF = EACH FACE
- ▲ = CUT TO FIT IN FIELD
- 3" CVR. UNLESS OTHERWISE SPECIFIED ON THE PLANS.

SUBSTRUCTURE DETAILS
 ABUTMENT NO. 1

PROJECT NAME: CASTLETON	PLOT DATE: 09-FEB-2007
PROJECT NUMBER: RS 0142(10)	DRAWN BY: STR 3
FILE NAME: 78f193/sf193sub.dgn	CHECKED BY: C. CARLSON
PROJECT LEADER: R. WHITCOMB	SHEET 48 OF 68
DESIGNED BY: J. PERRIGO	
78f193/str/sf193abl.i	