



ABUTMENT NO. 2 PLAN

SCALE 3/8" = 1'-0"
1 0 1 2 3 4

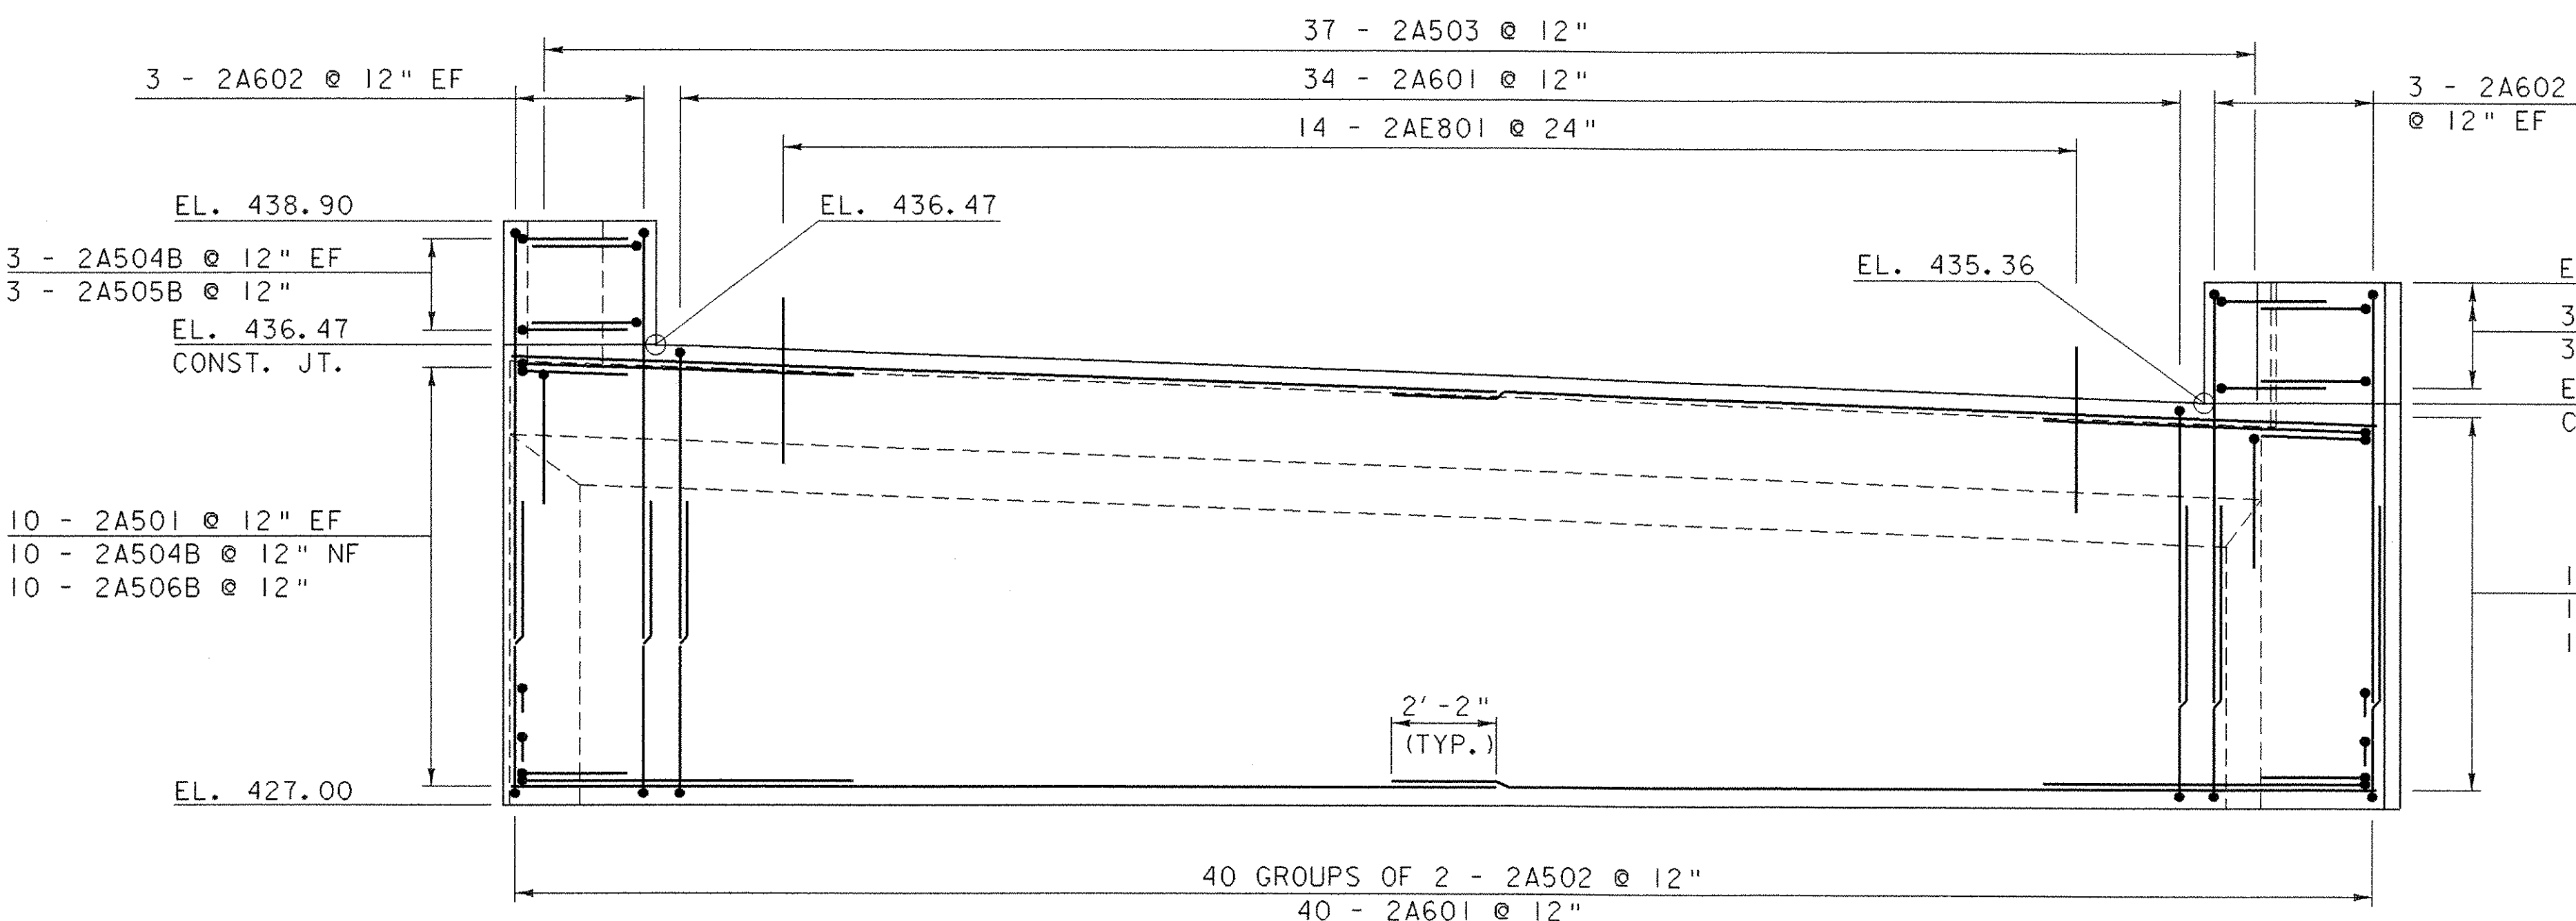


ABUTMENT NO. 2 ELEVATION

SCALE 3/8" = 1'-0"
1 0 1 2 3 4

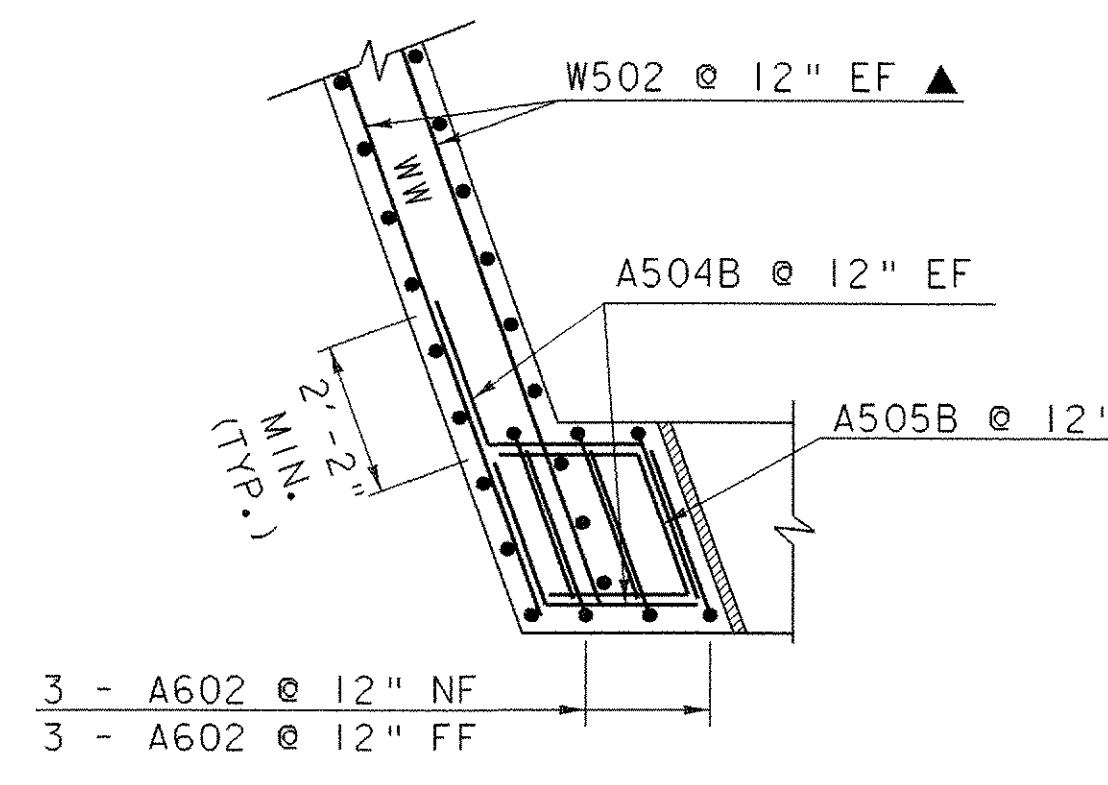


WINGWALL NO. 2 & NO. 3
(ABOVE BRIDGE SEAT)

SCALE 3/8" = 1'-0"
1 0 1 2 3 4

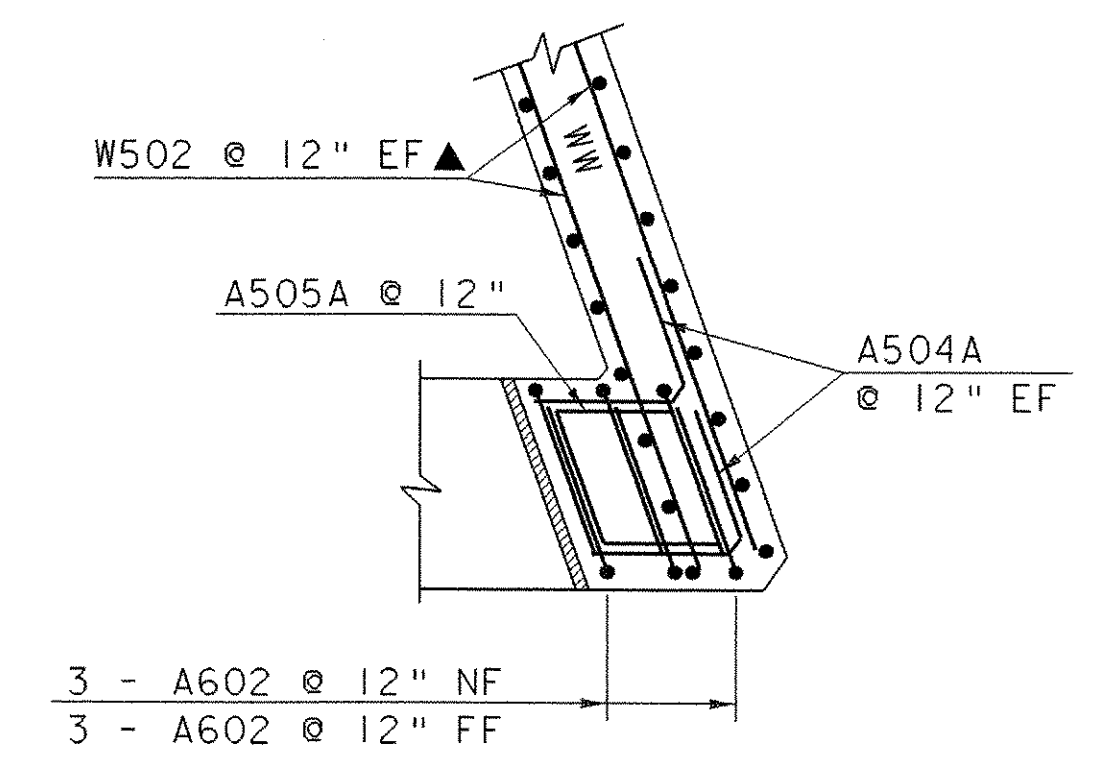


WINGWALL NO. 1 & NO. 4
(ABOVE BRIDGE SEAT)

SCALE 3/8" = 1'-0"
1 0 1 2 3 4

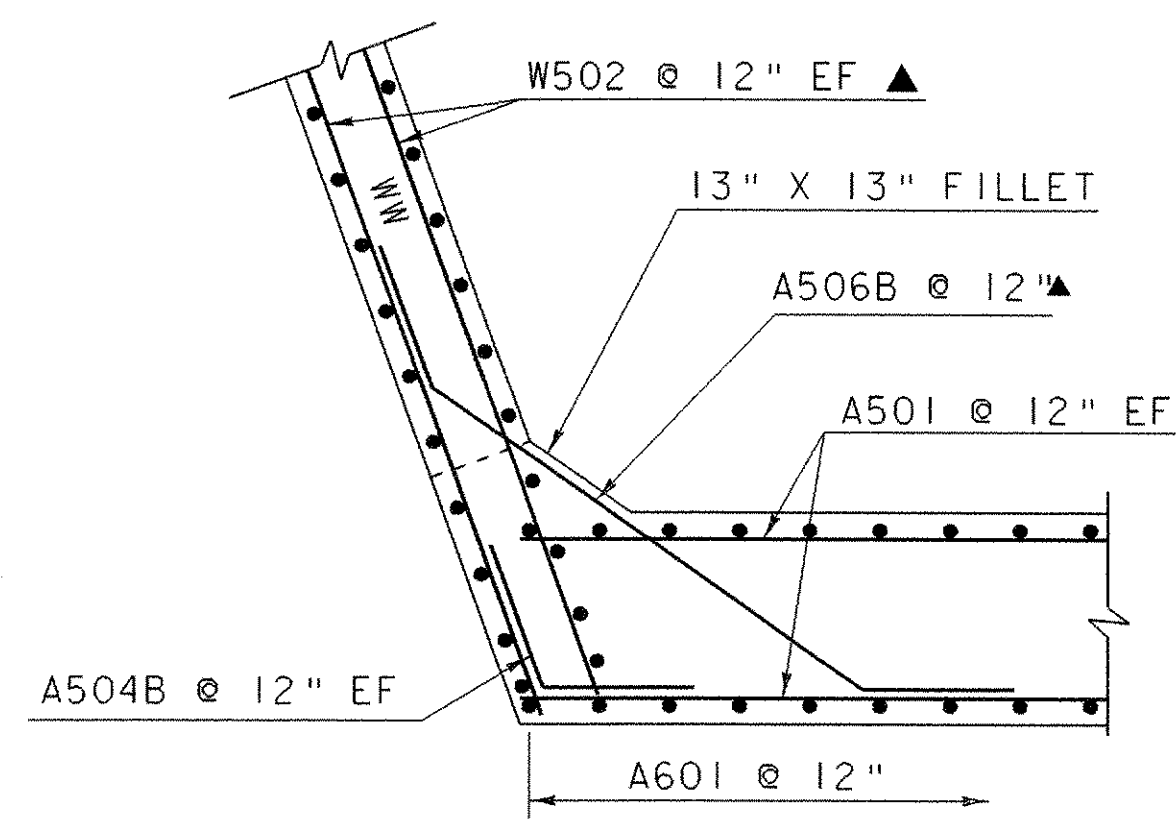

WINGWALL NO. 2 & NO. 3
(BELOW BRIDGE SEAT)

SCALE 3/8" = 1'-0"
1 0 1 2 3 4

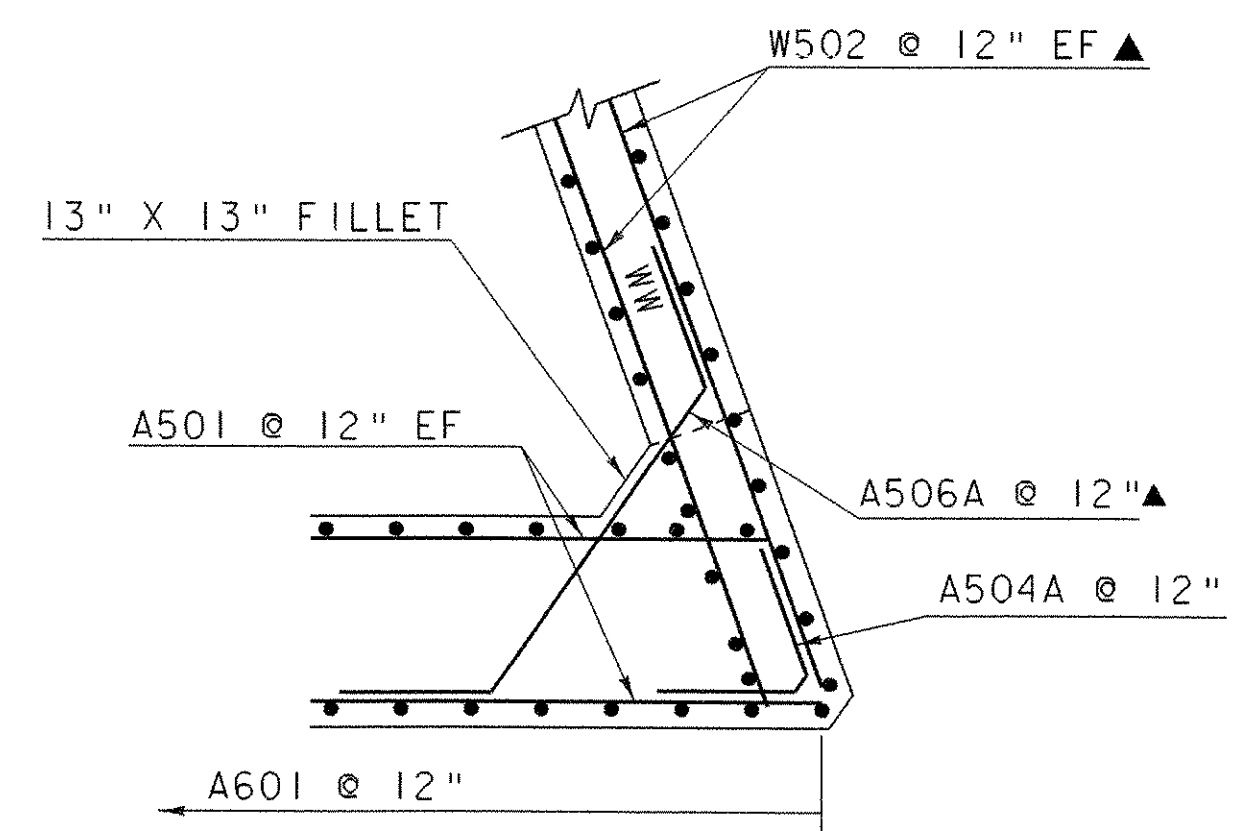

WINGWALL NO. 1 & NO. 4
(BELOW BRIDGE SEAT)

SCALE 3/8" = 1'-0"
1 0 1 2 3 4

NOTE:

NF = NEAR FACE
FF = FAR FACE
EF = EACH FACE
▲ = CUT TO FIT IN FIELD
3" CVR. UNLESS OTHERWISE SPECIFIED ON THE PLANS.

SUBSTRUCTURE DETAILS
ABUTMENT NO. 2

PROJECT NAME: CASTLETON	PLOT DATE: 09-FEB-2007
PROJECT NUMBER: RS 0142(10)	DRAWN BY: STR 3
FILE NAME: 78f193/sf193sub.dgn	CHECKED BY: C. CARLSON
PROJECT LEADER: R. WHITCOMB	SHEET 49 OF 68
DESIGNED BY: J. PERRIGO	
78f193/str/sw193ab2.i	