



402+00


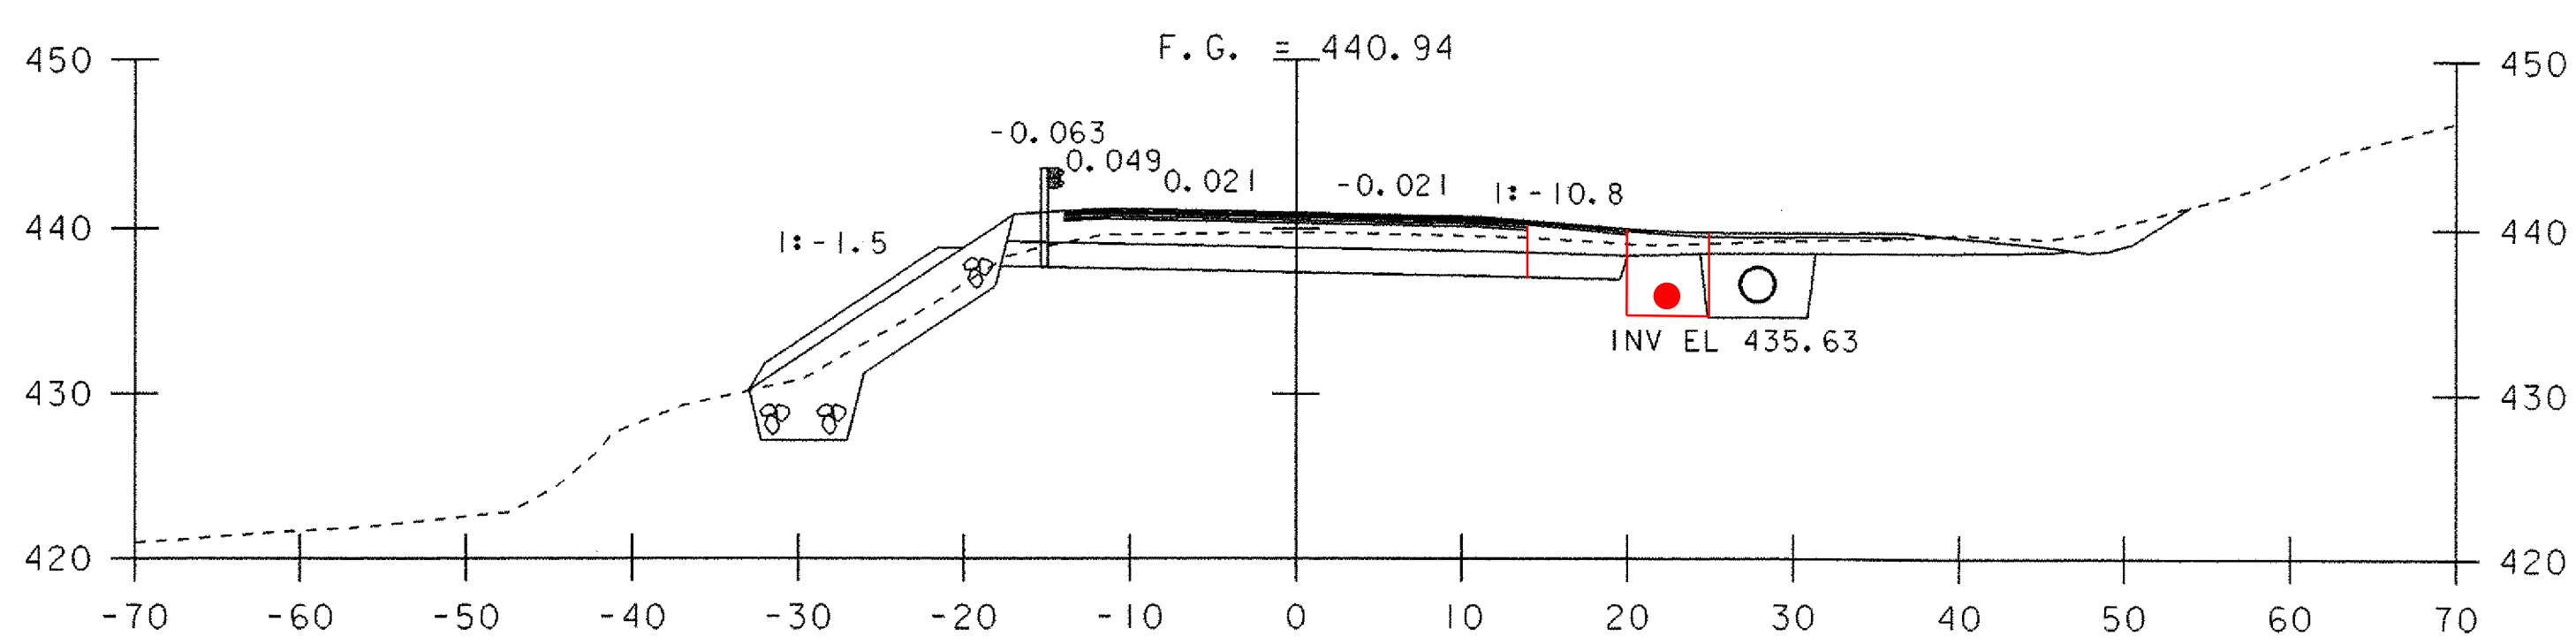


401+98

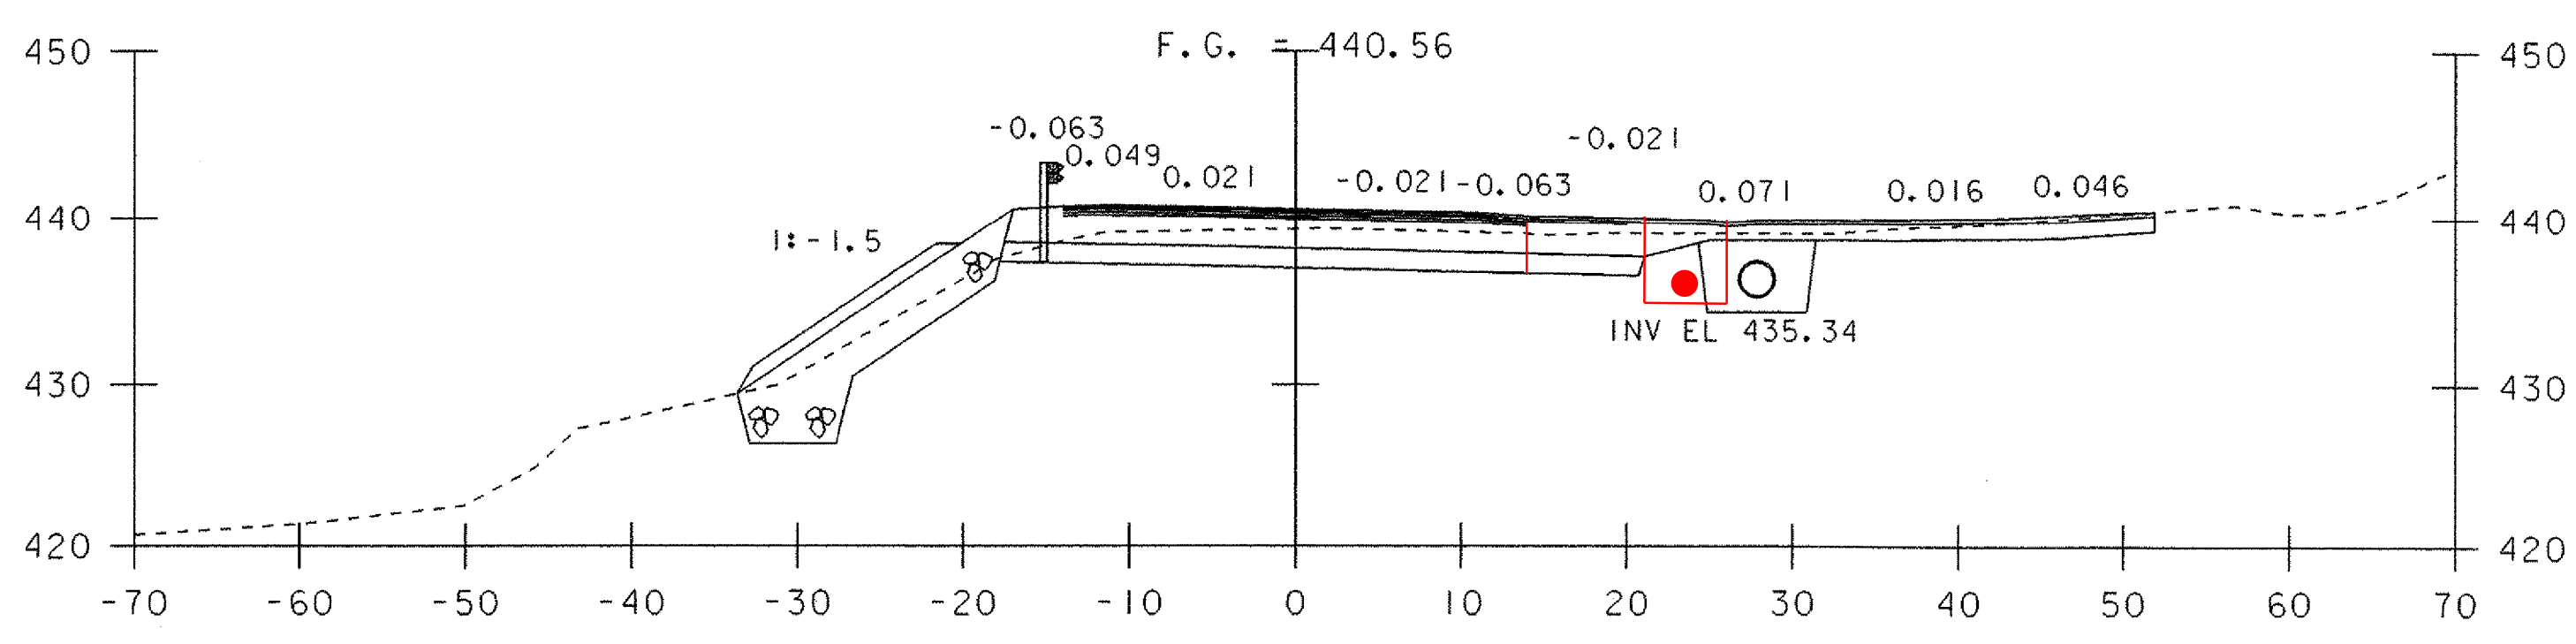


401+90


401+90 DRIVE 2  
401+90 TAPER SUBBASE

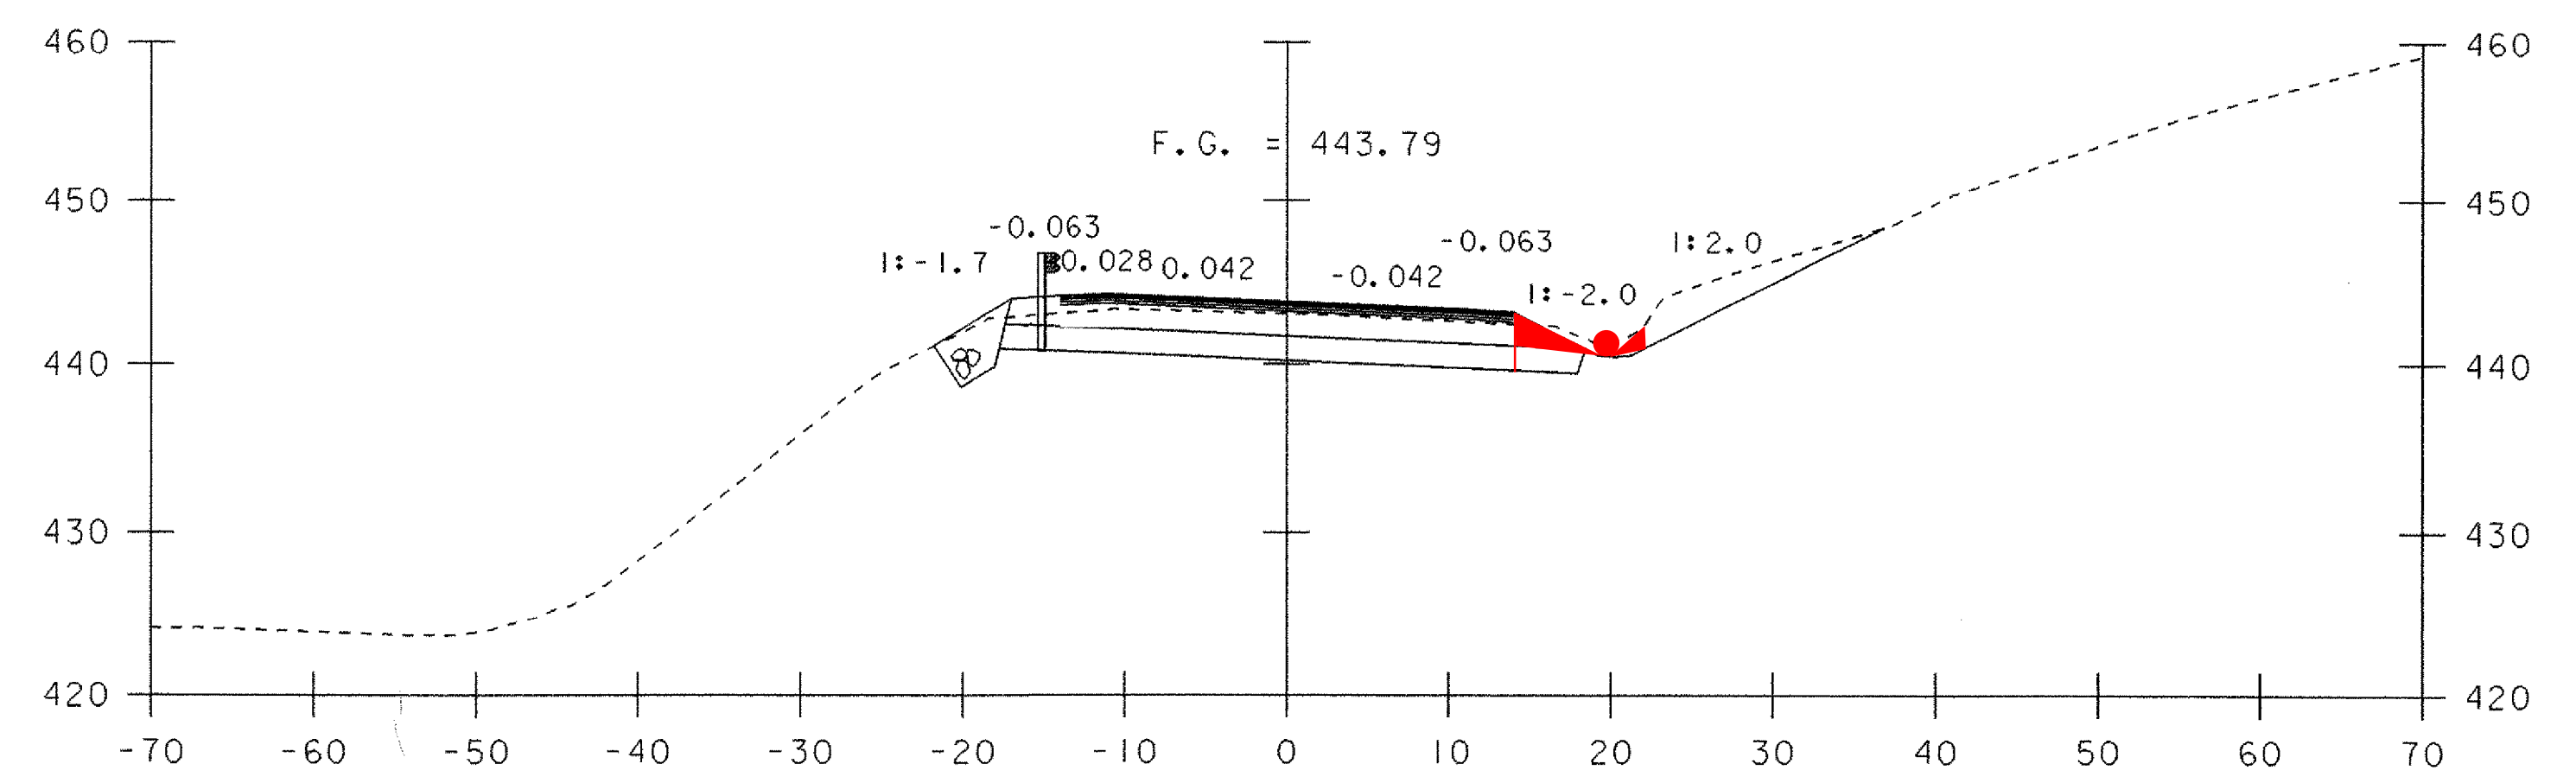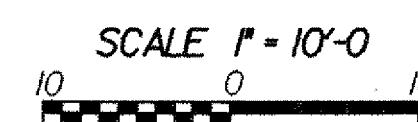

402+50

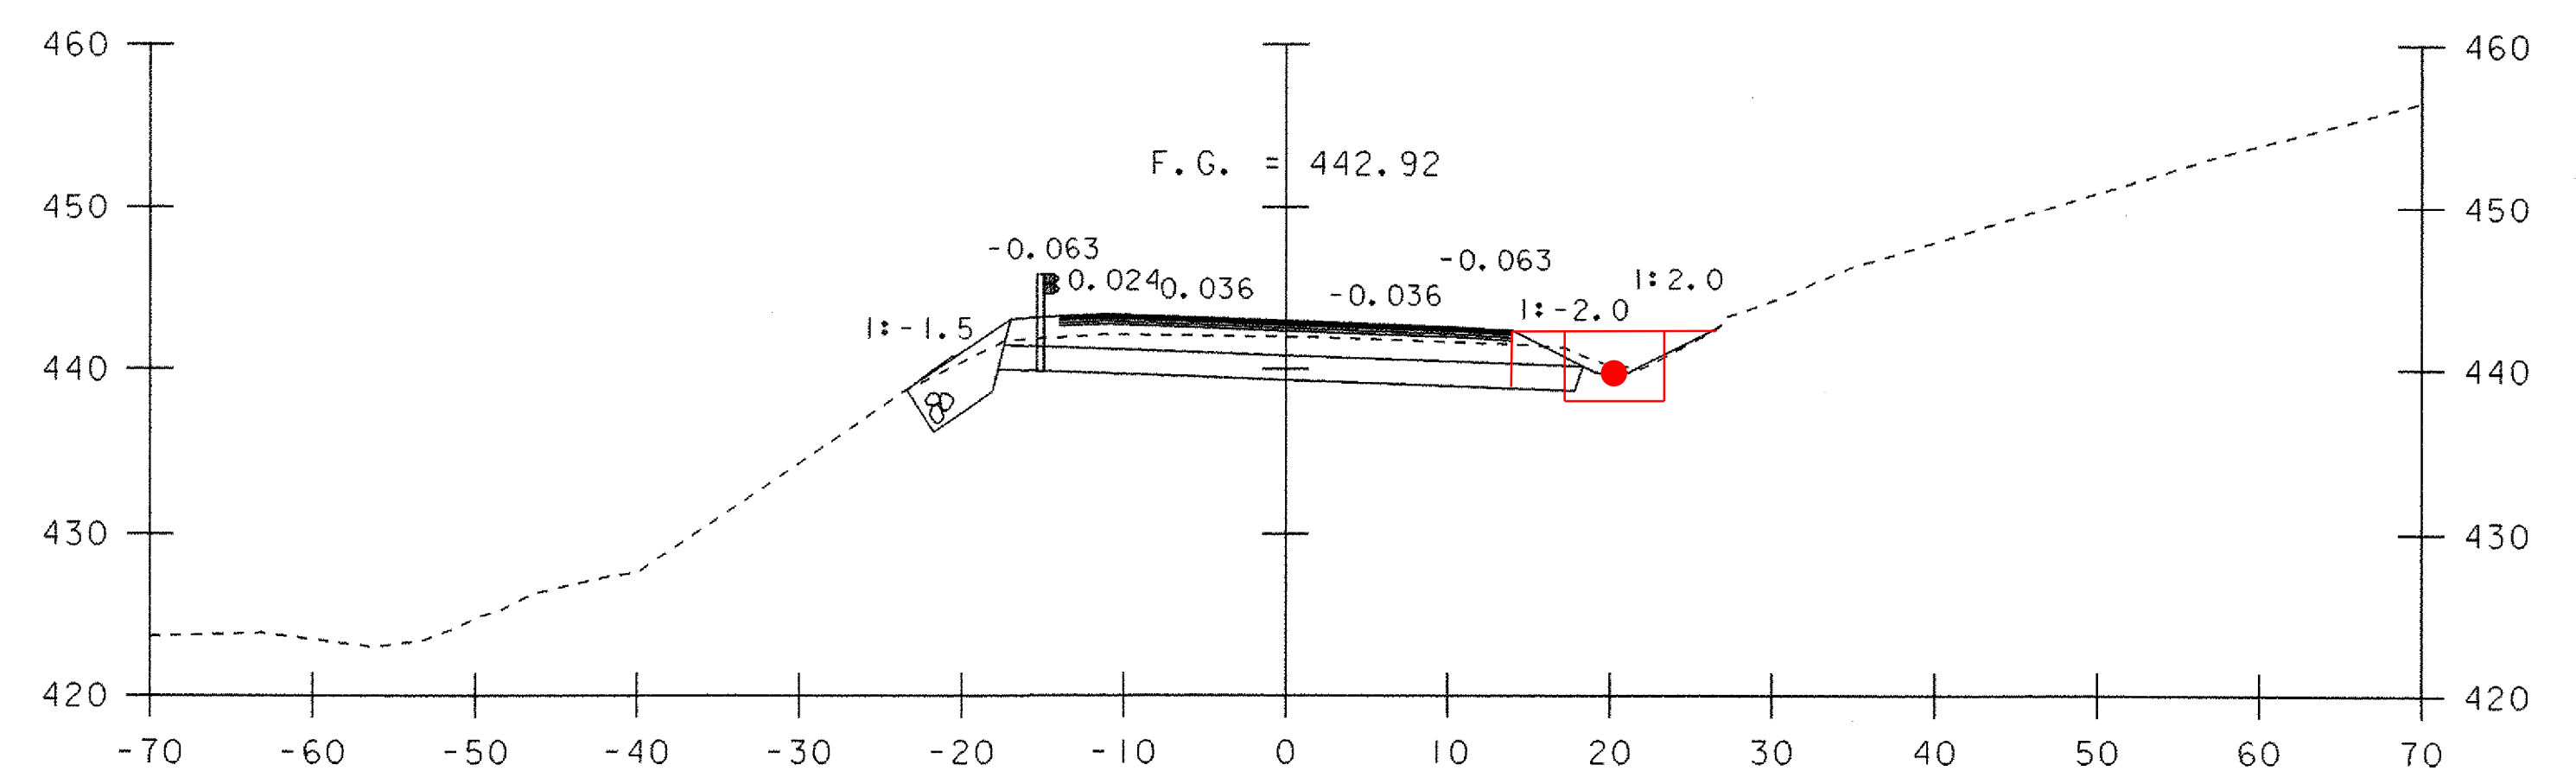

402+35

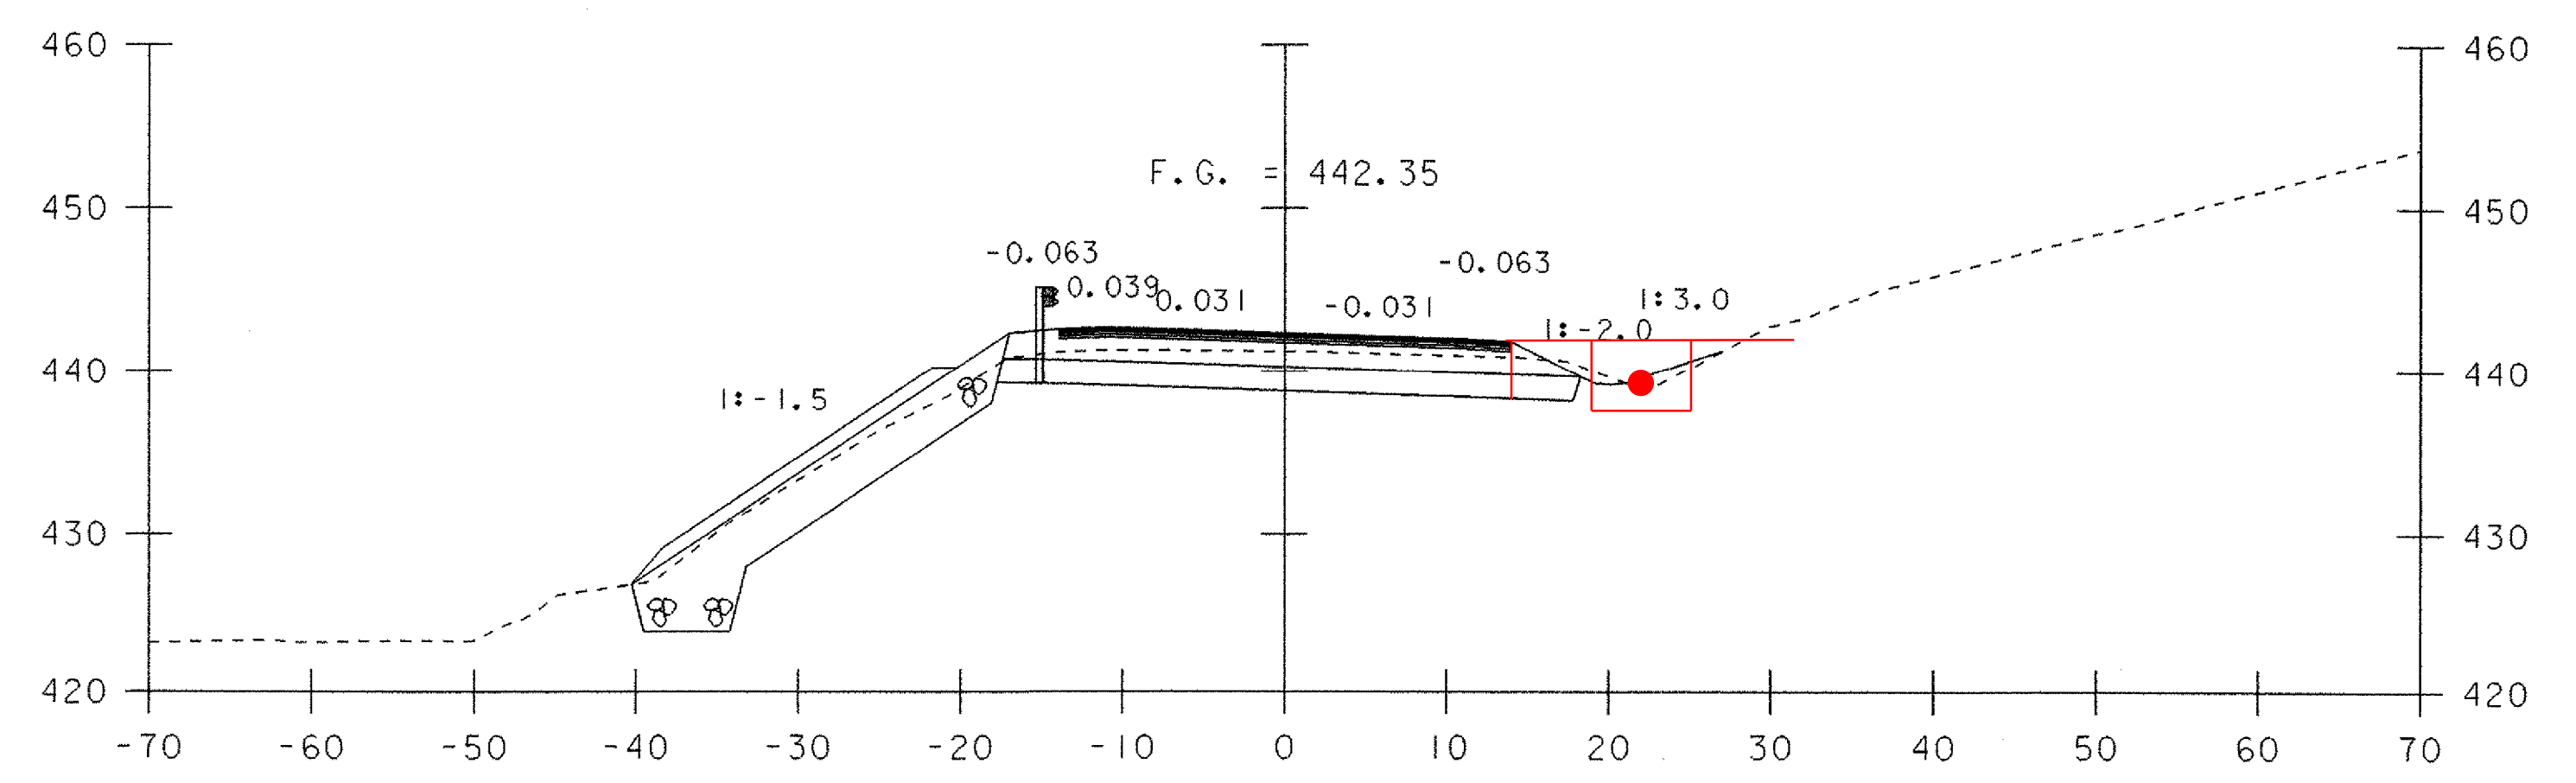

402+25

MAINLINE SECTIONS 5

PROJECT NAME: CASTLETON  
PROJECT NUMBER: RS 0142(10)

FILE NAME: sf193m05.1	PLOT DATE: 09-FEB-2007
PROJECT LEADER: R. WHITCOMB	DRAWN BY: T. LACKEY
DESIGNED BY: T. LACKEY	CHECKED BY: W. LAMMER
78f193/structures/sf193xsl.dgn	SHEET 59 OF 68