


MAINLINE SECTIONS 7

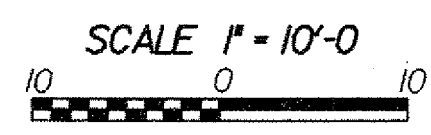

PROJECT NAME: CASTLETON	PLOT DATE: 09-FEB-2007
PROJECT NUMBER: RS 0142(10)	DRAWN BY: T. LACKEY
FILE NAME: sf193m07.i	CHECKED BY: W. LAMMER
PROJECT LEADER: R. WHITCOMB	SHEET 61 OF 68
DESIGNED BY: T. LACKEY	
78f193/structures/sf193xsl.dgn	