



500+39

F.G. = 433.84

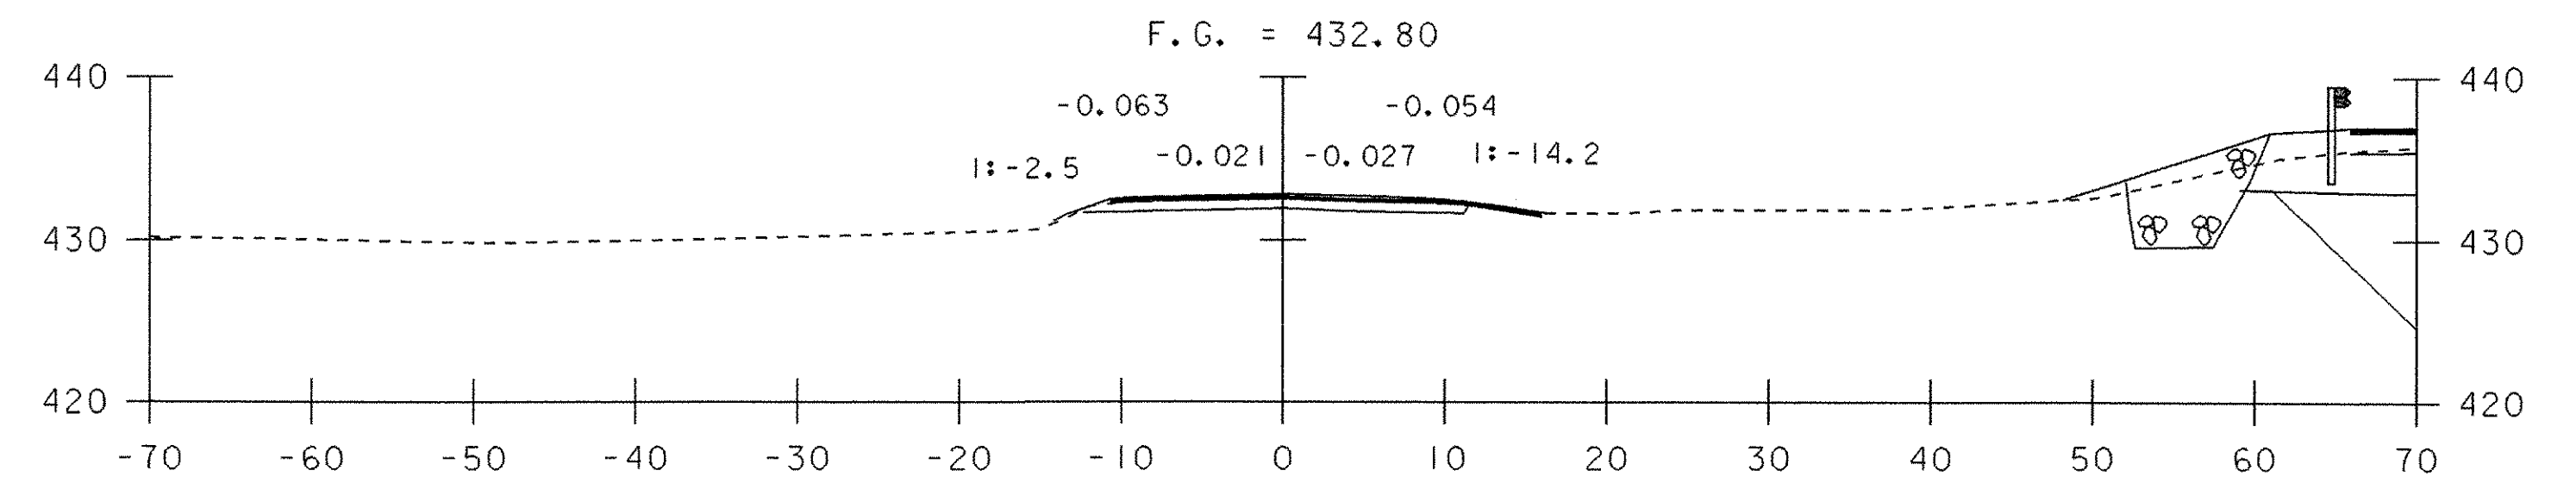


500+60

F.G. = 432.80

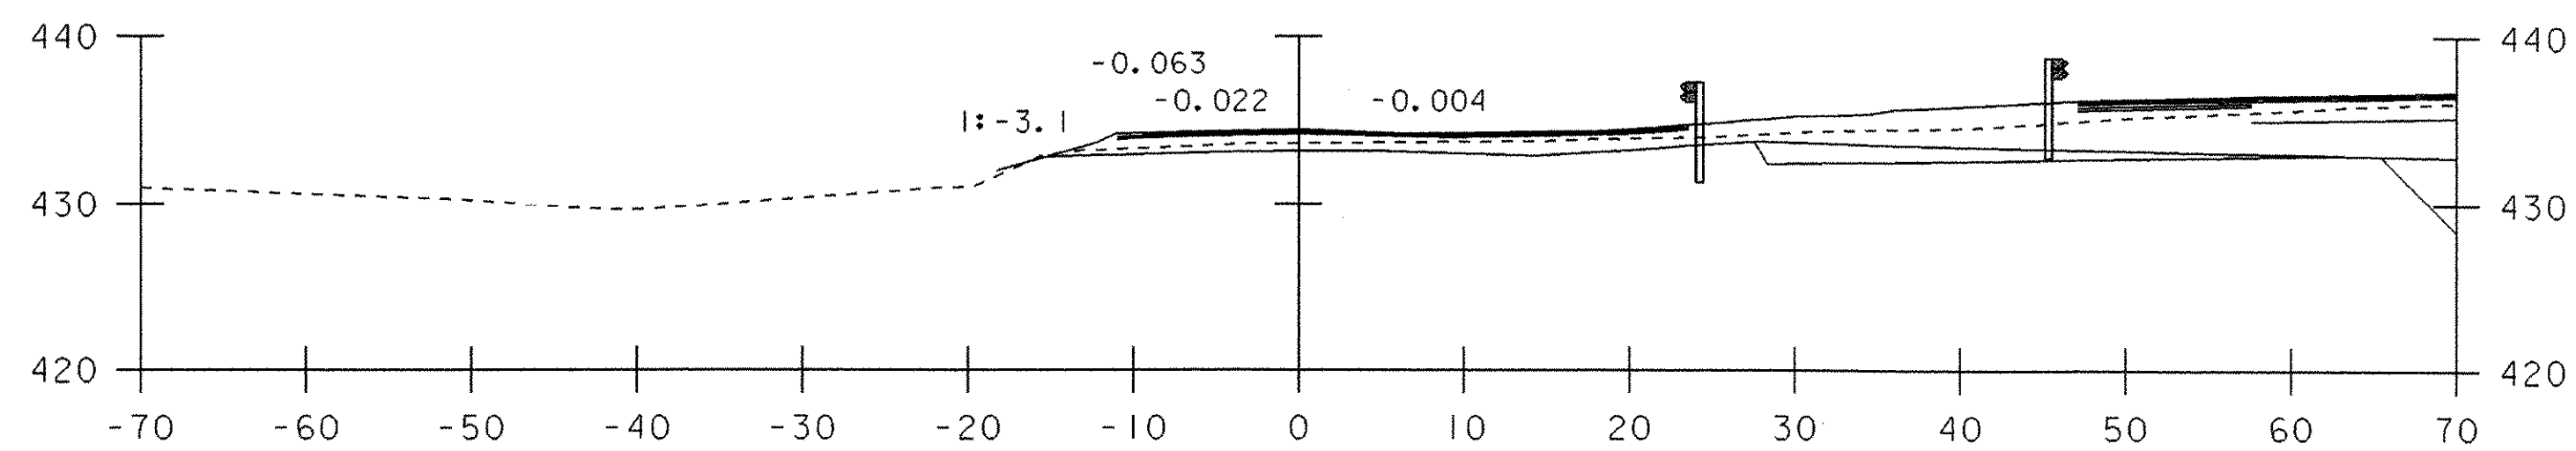


500+29

F.G. = 434.43

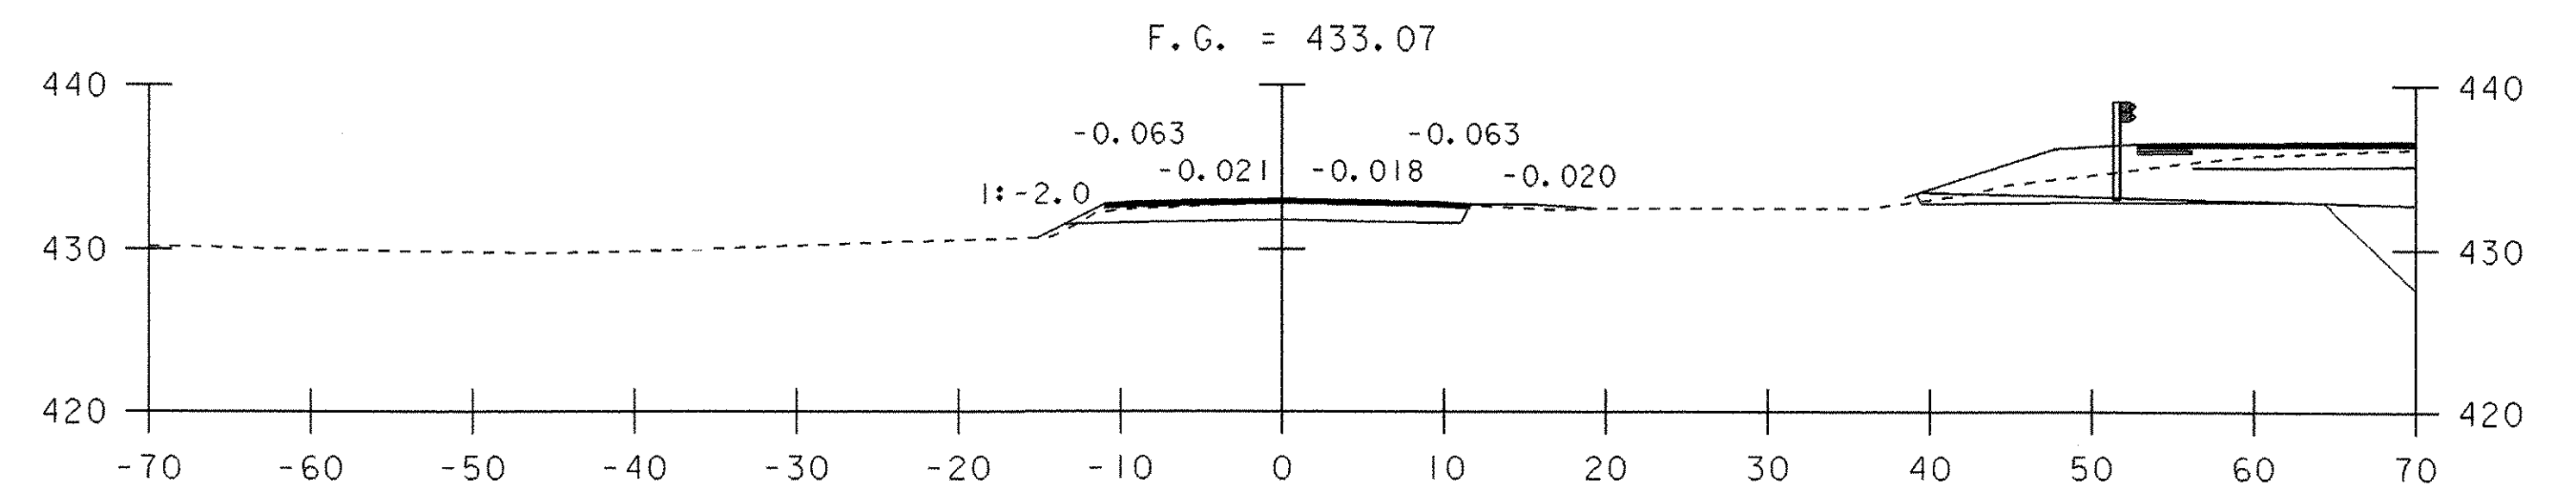


500+50

F.G. = 433.07

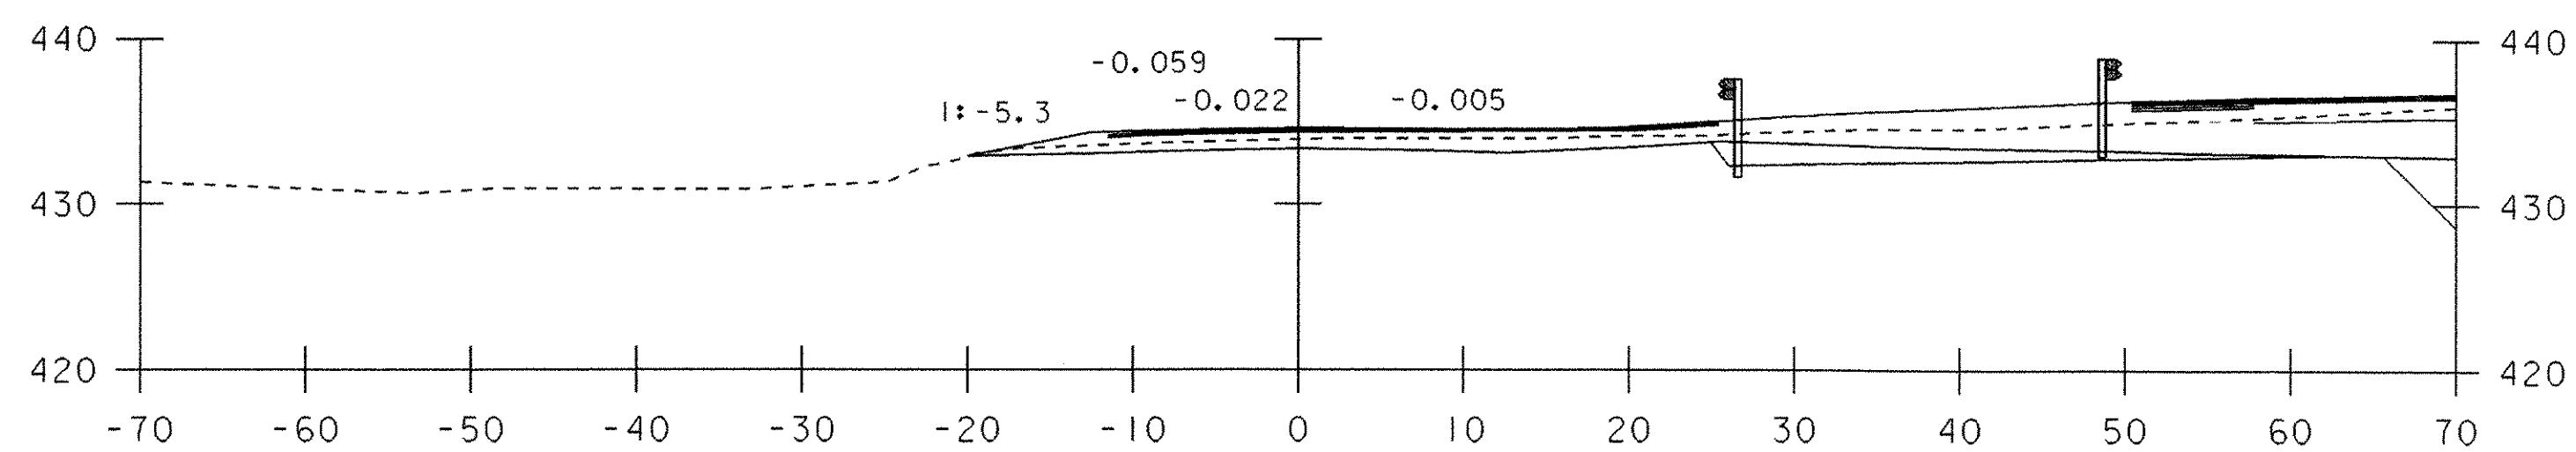


500+25

F.G. = 434.59

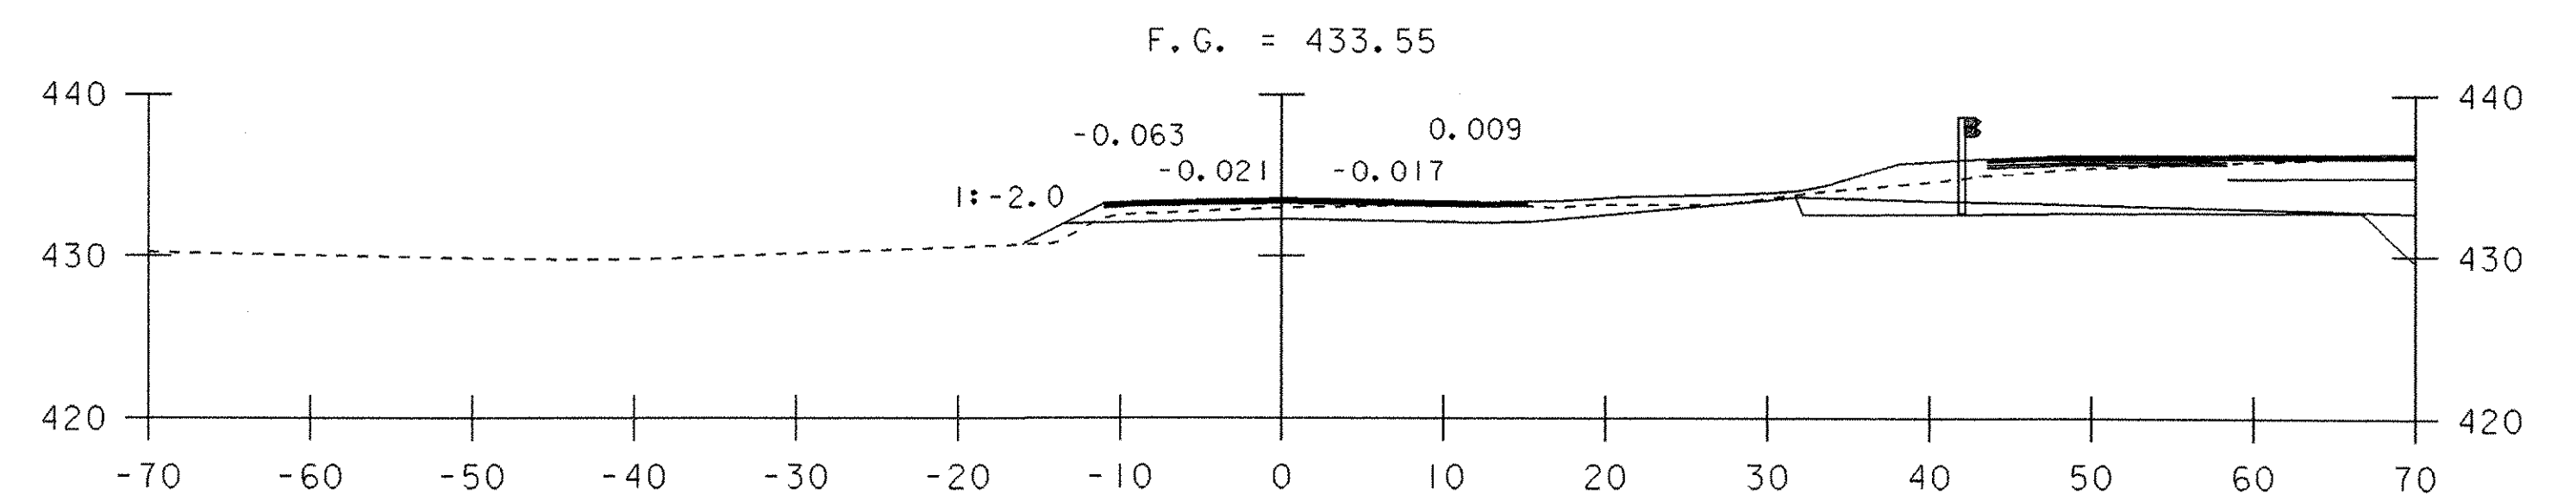


500+43

F.G. = 433.55

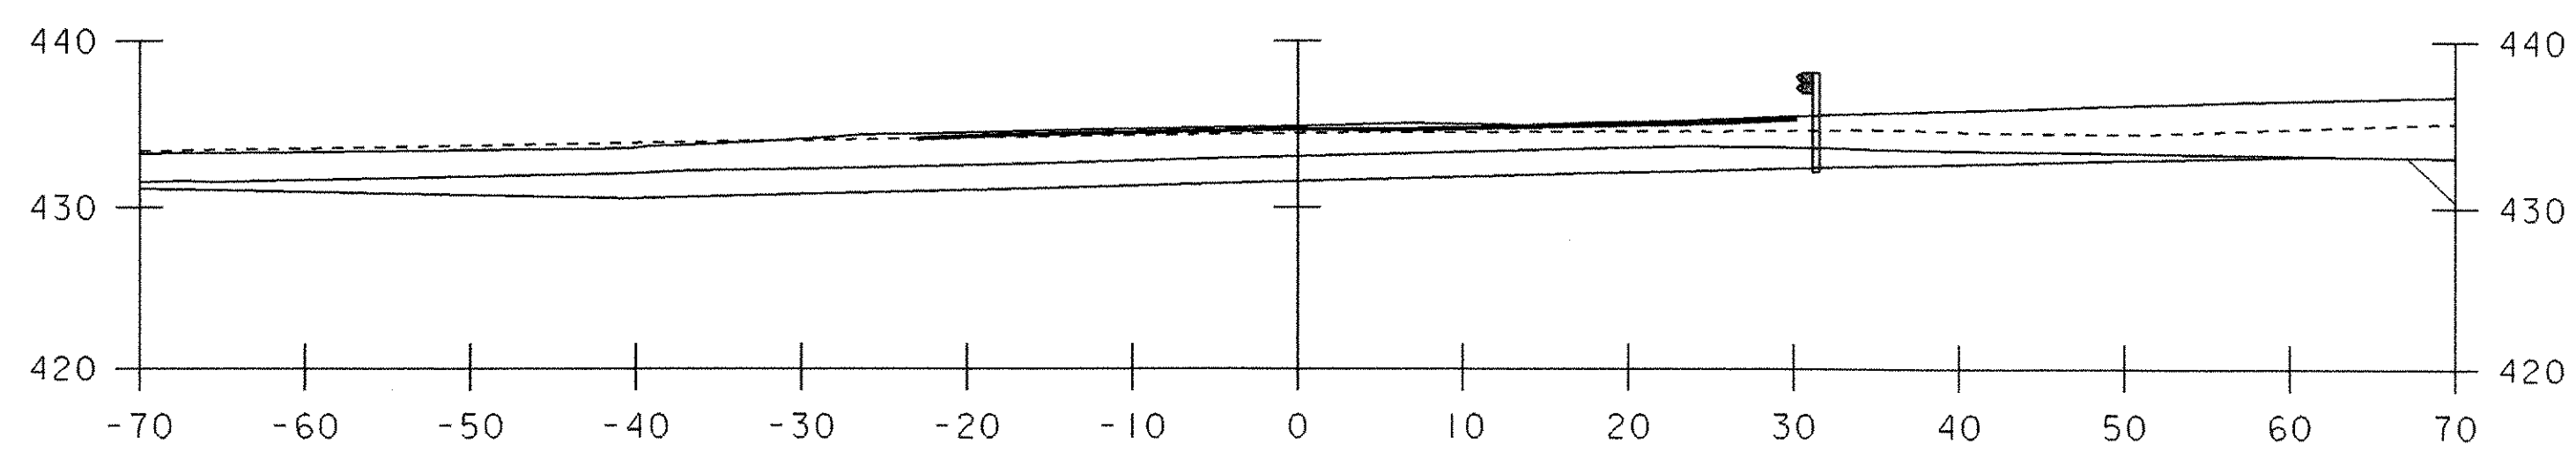

500+16

F.G. = 434.86

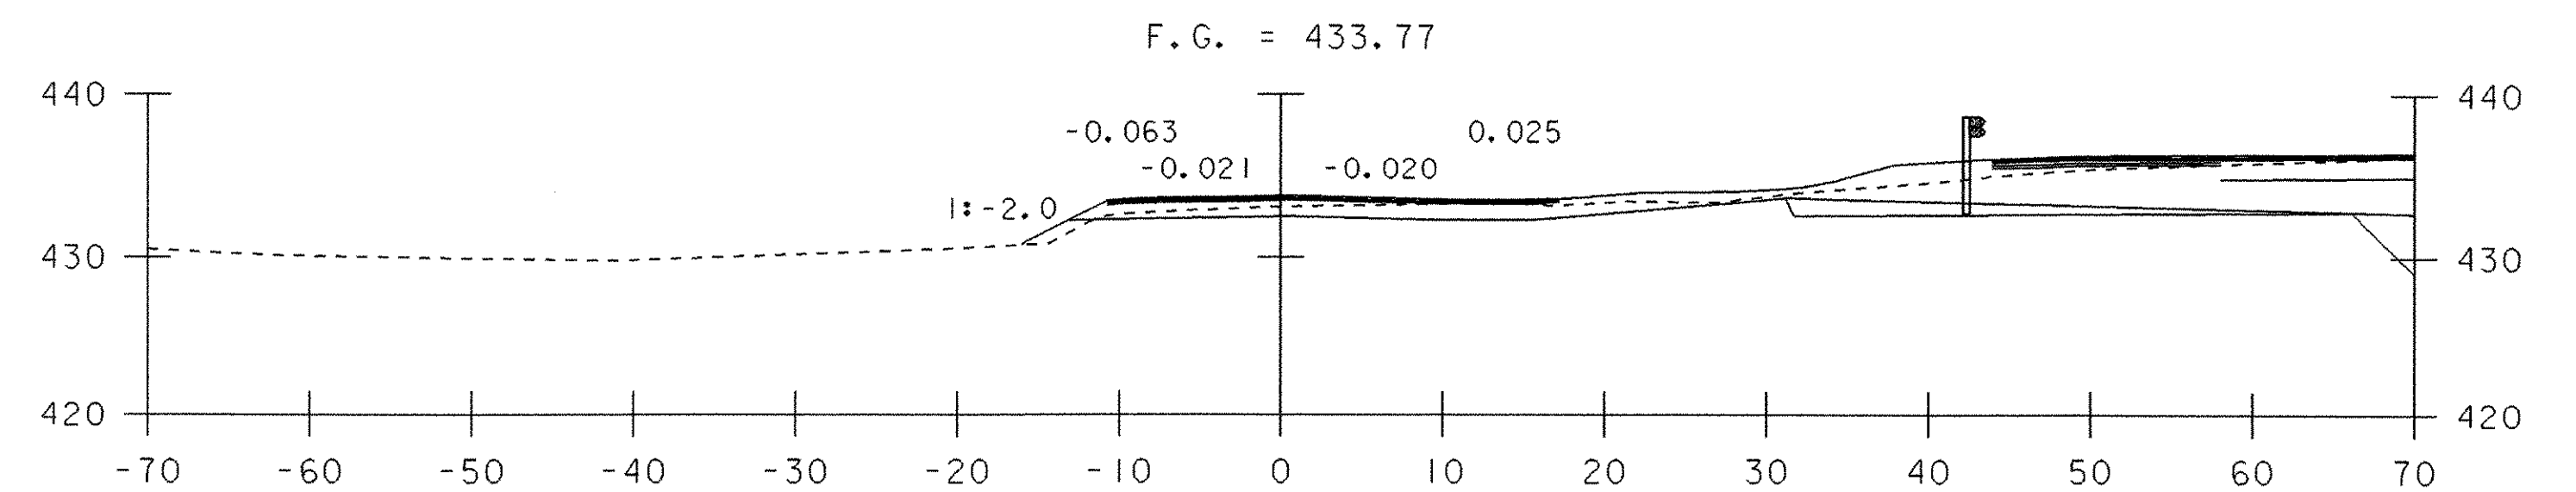


500+40

F.G. = 433.77

TH 8 SECTIONS 1

500+14 BEGIN TH 8

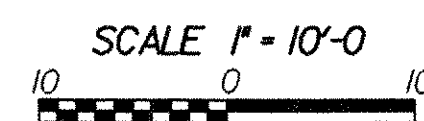

PROJECT NAME: CASTLETON	
PROJECT NUMBER: RS 0142(10)	
FILE NAME: sf193+01.1	PLOT DATE: 09-FEB-2007
PROJECT LEADER: R. WHITCOMB	DRAWN BY: T. LACKEY
DESIGNED BY: T. LACKEY	CHECKED BY: W. LAMMER
78f193/structures/sf193xsl.dgn	SHEET 66 OF 68