



501+25

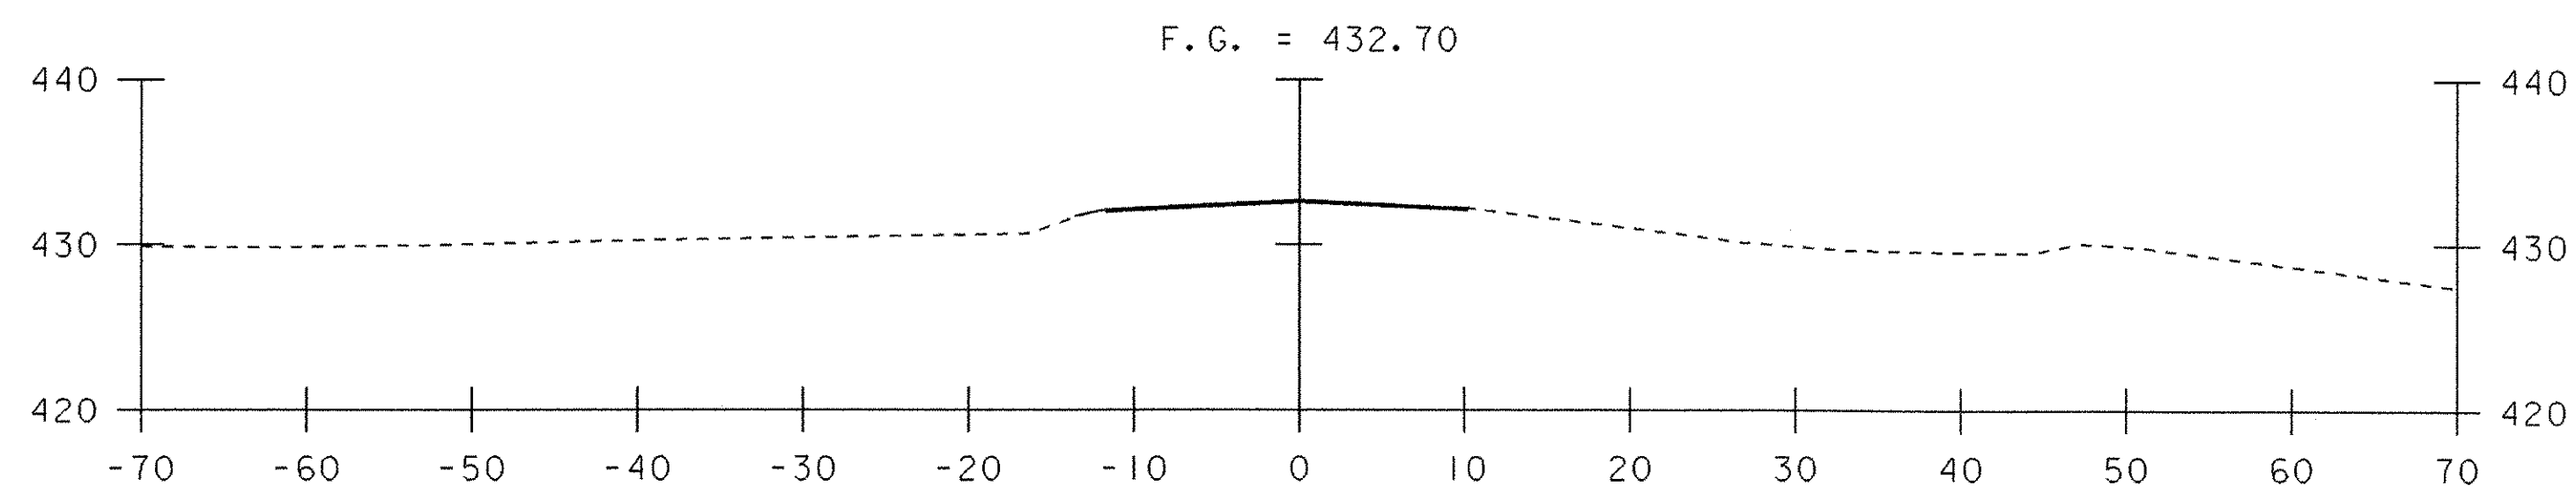

501+00

501+00 END TH 8

F. G. = 432.40

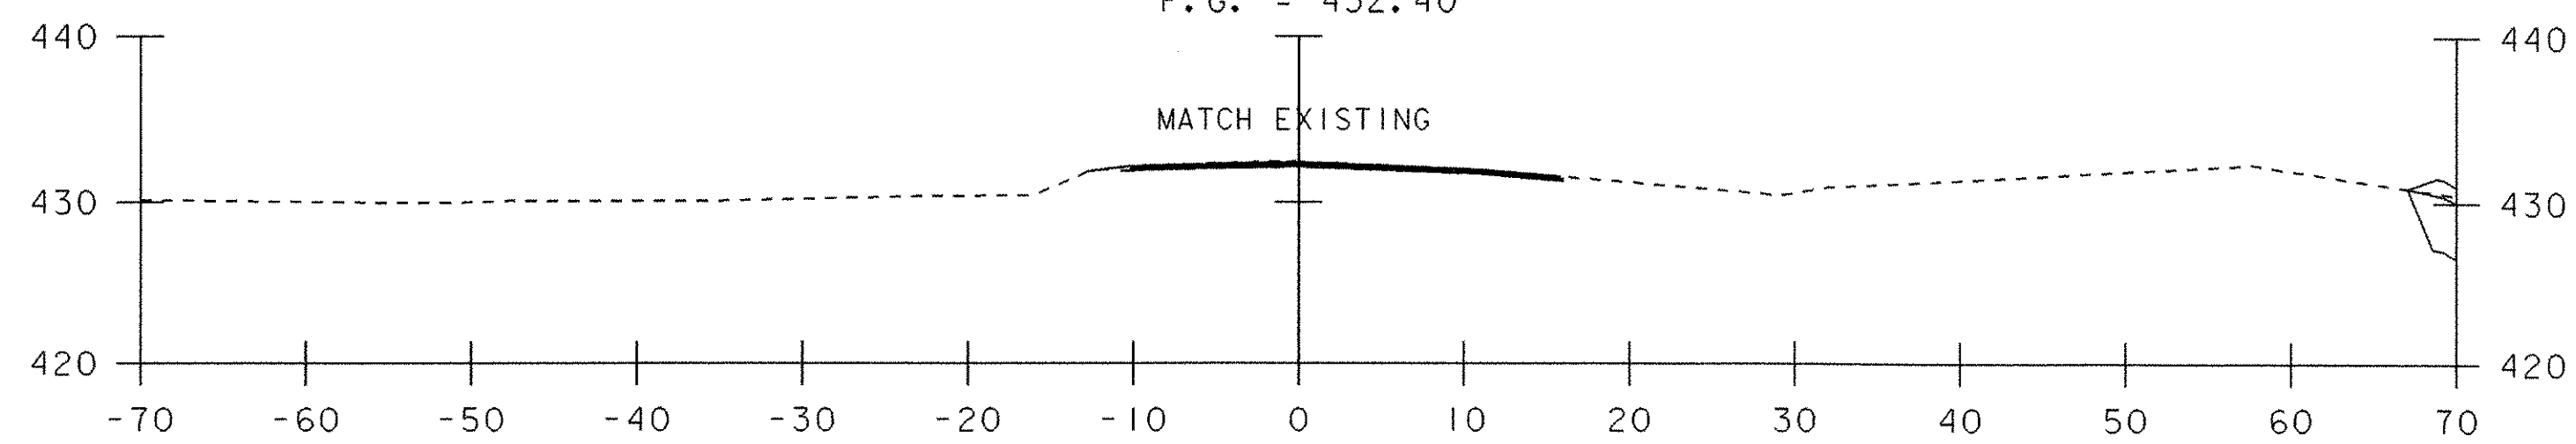

500+75

SCALE 1" = 10'-0"

TH 8 SECTIONS 2

PROJECT NAME: CASTLETON
PROJECT NUMBER: RS 0142(10)

FILE NAME: sf193t02.1
PROJECT LEADER: R. WHITCOMB
DESIGNED BY: T. LACKEY
78f193/structures/sf193xsl.dgn

PLOT DATE: 09-FEB-2007
DRAWN BY: T. LACKEY
CHECKED BY: W. LAMMER
SHEET 67 OF 68