



700+36


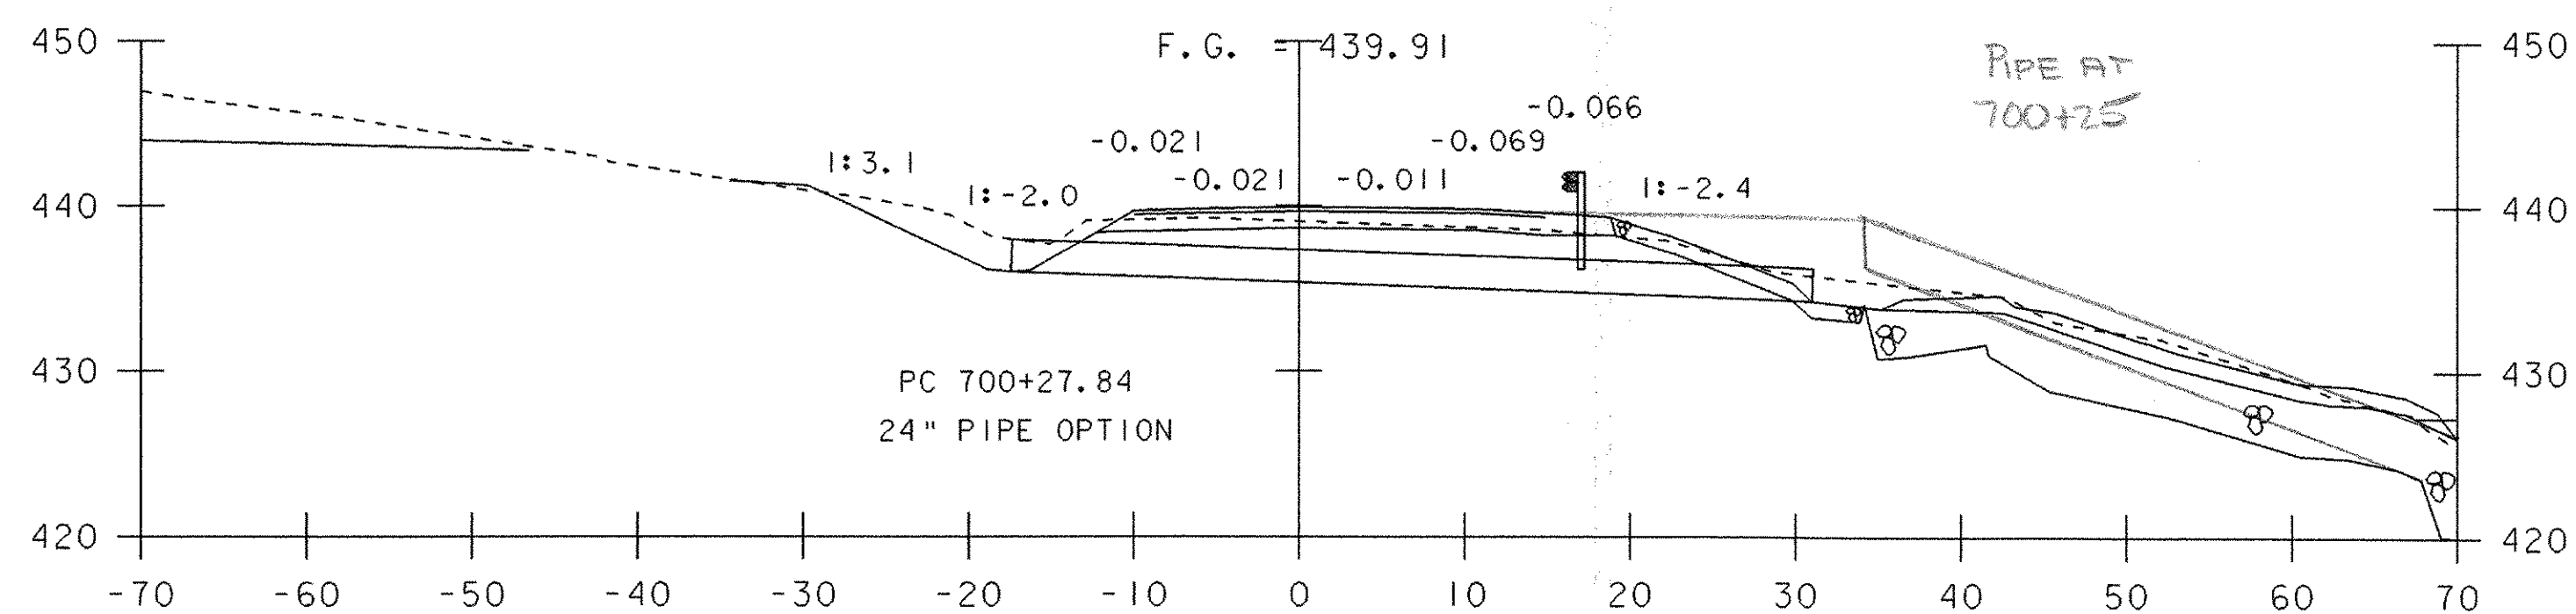


700+28

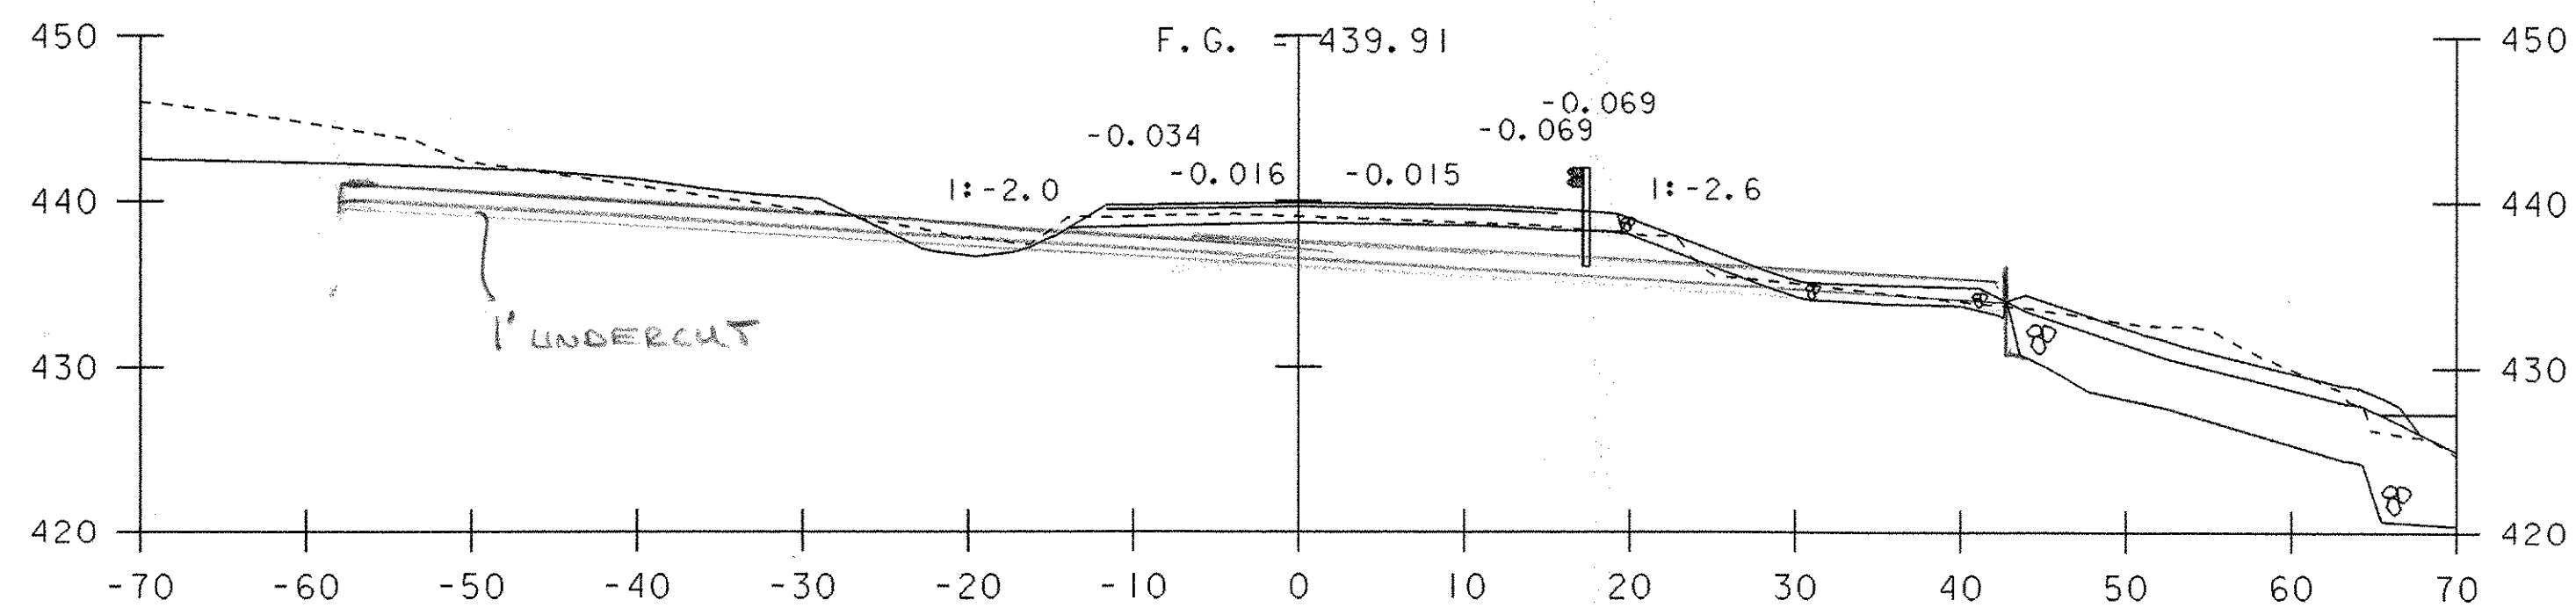


700+25

700+14 BEGIN DRIVE 2

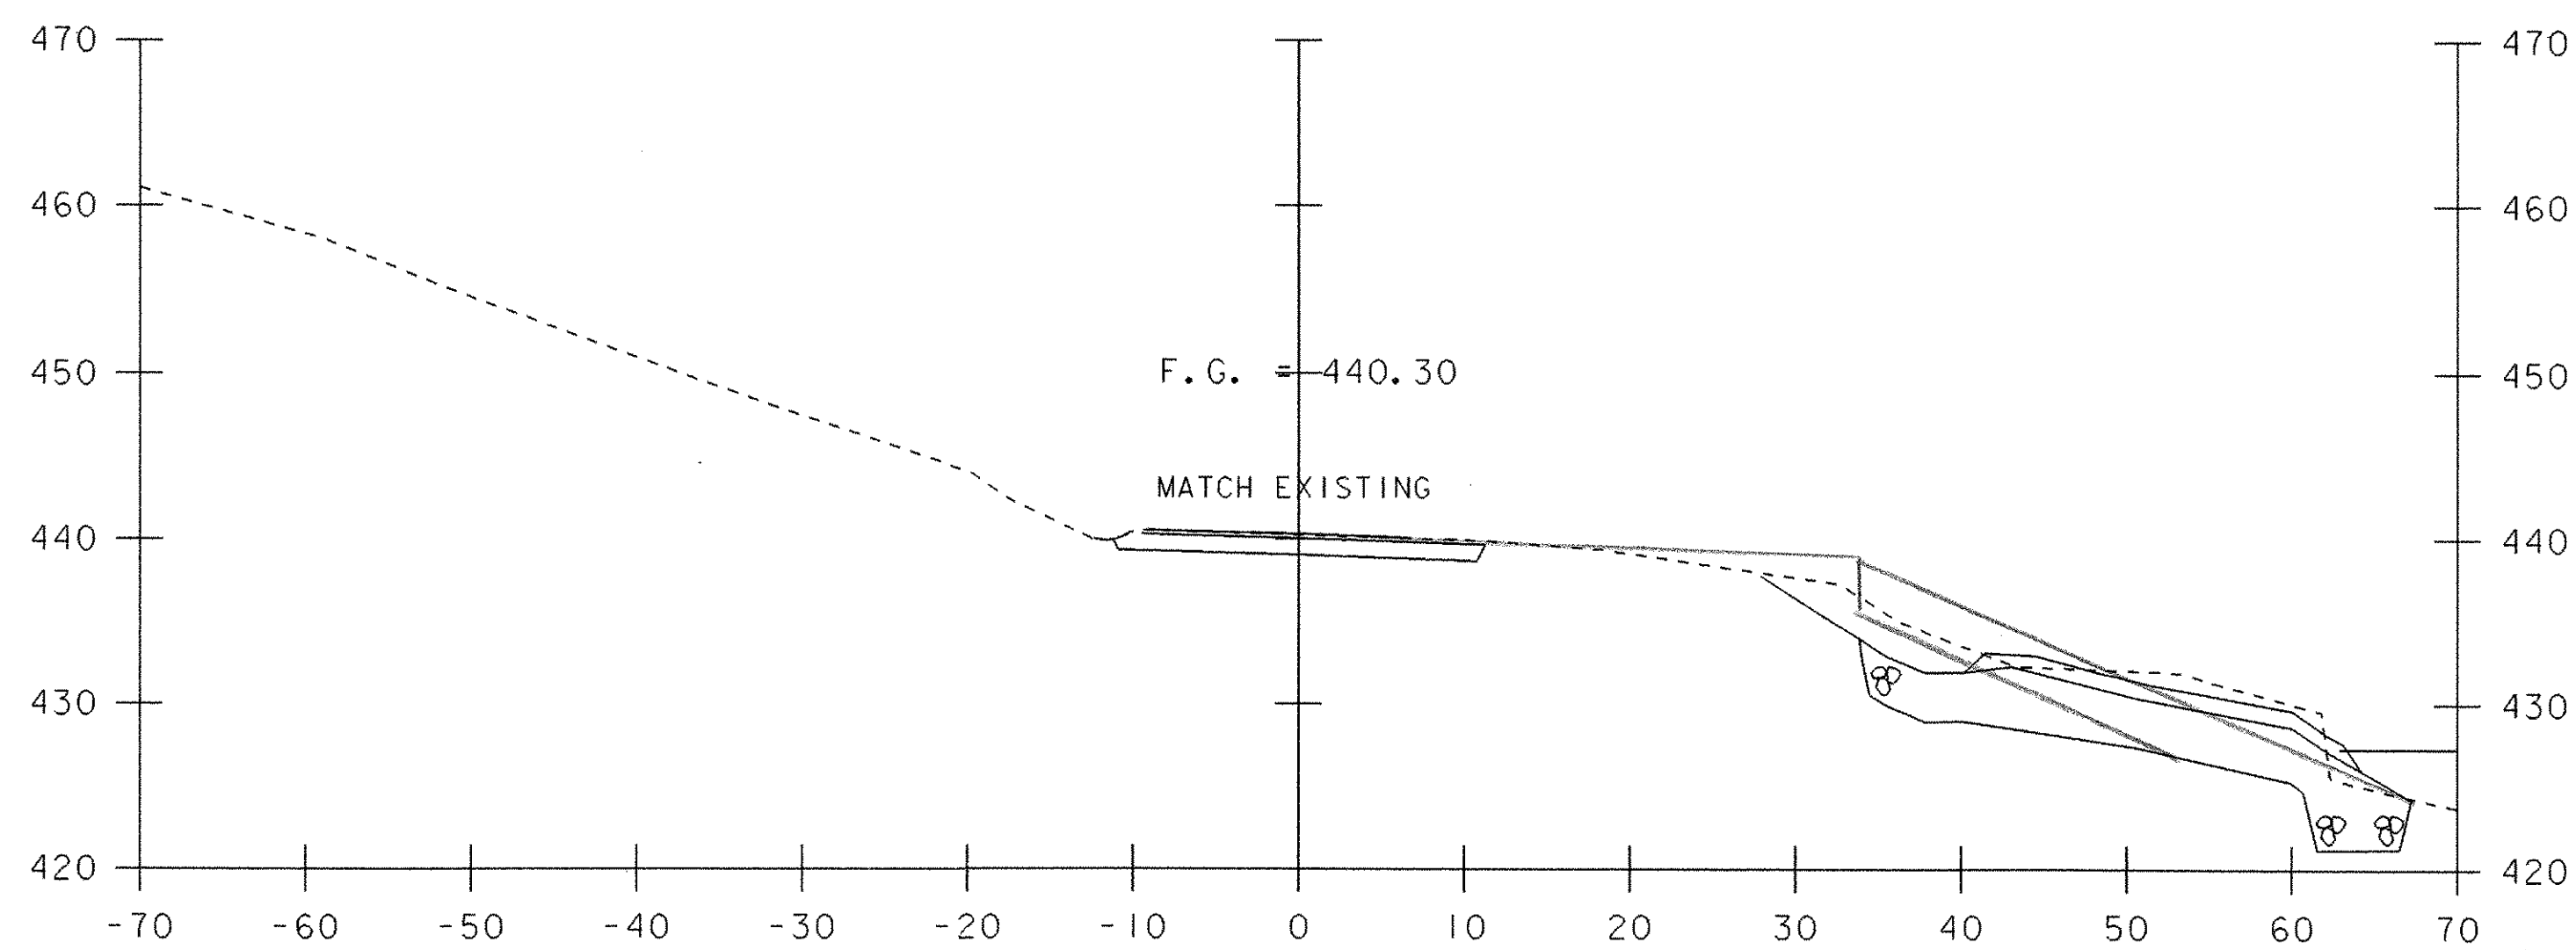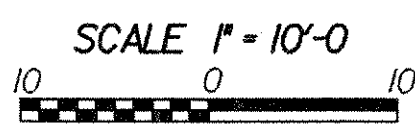

700+50

700+50 END DRIVE 2

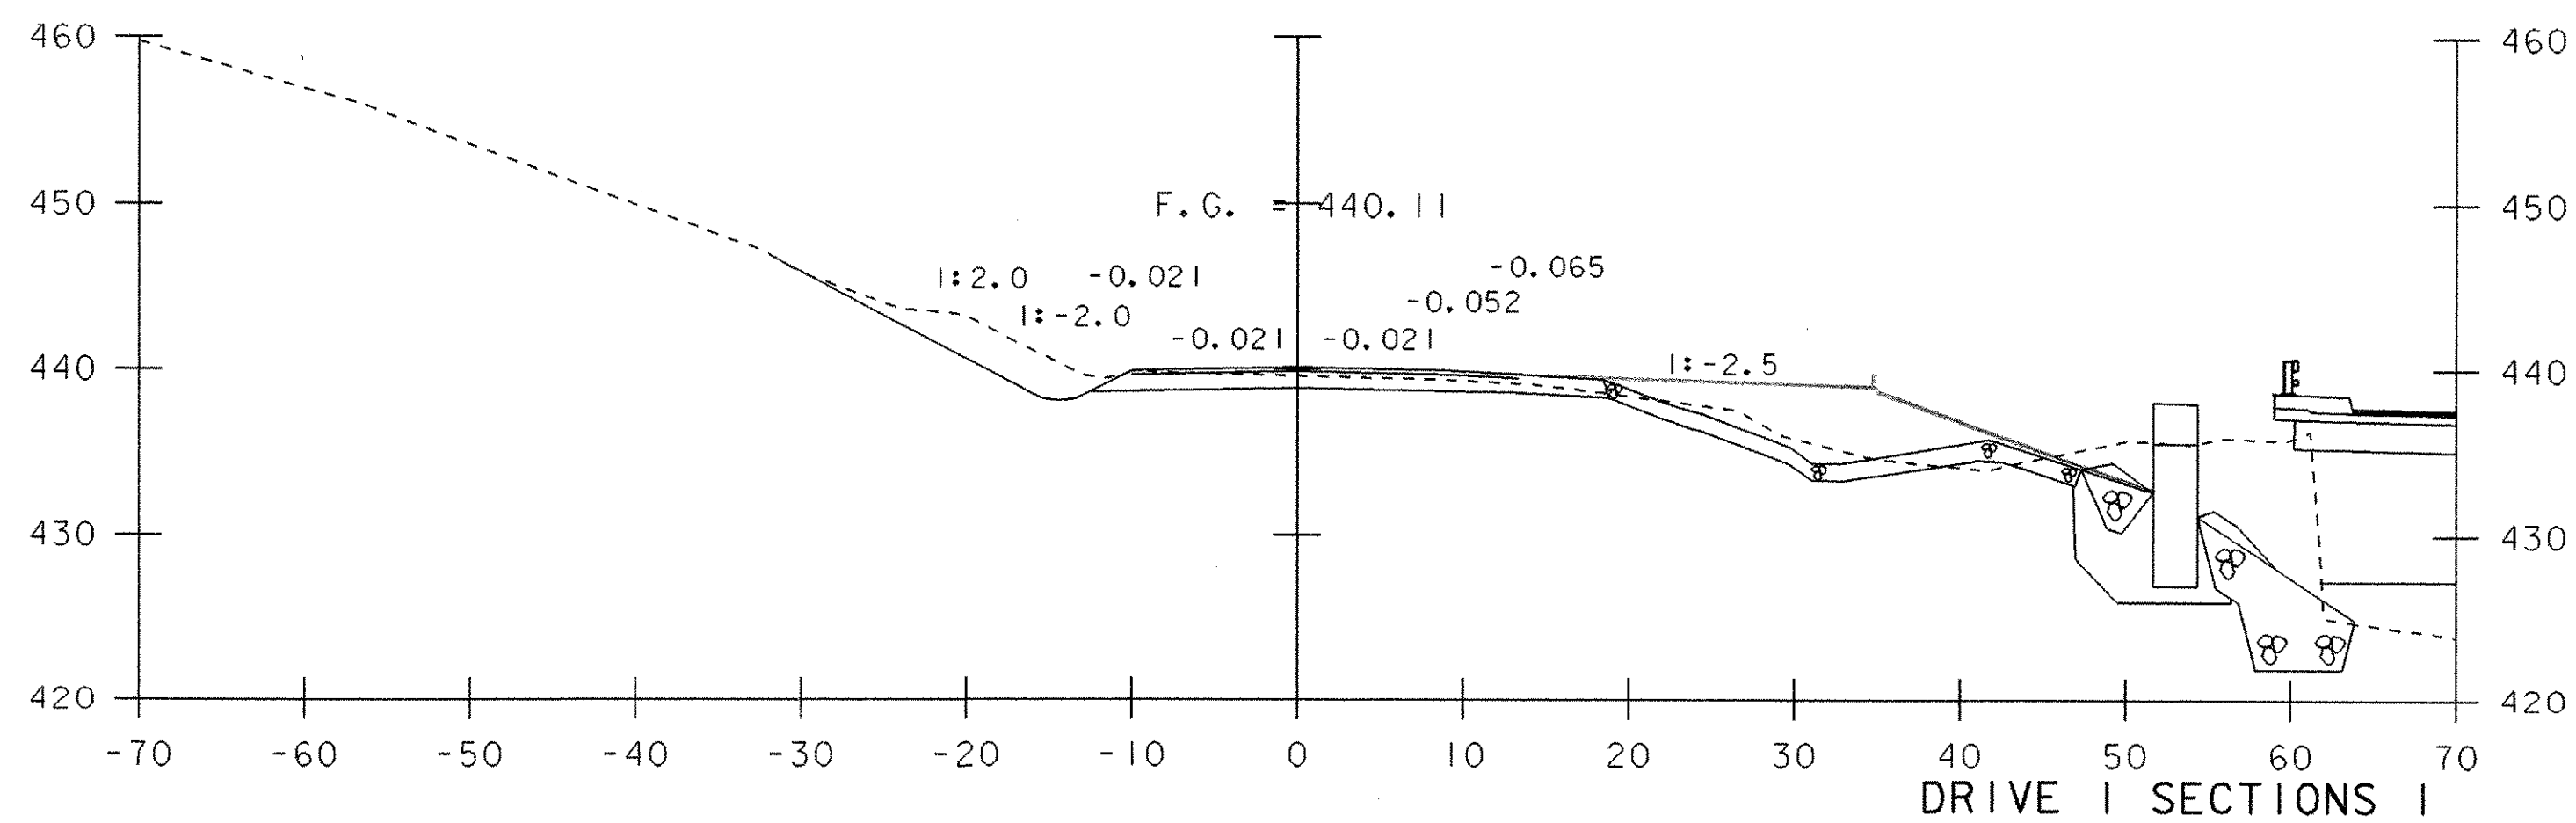

700+41

PROJECT NAME: CASTLETON	
PROJECT NUMBER: RS 0142(10)	
FILE NAME: sf193d01.i	PLOT DATE: 16-FEB-2007
PROJECT LEADER: R. WHITCOMB	DRAWN BY: T. LACKEY
DESIGNED BY: T. LACKEY	CHECKED BY: W. LAMMER
78f193/structures/sf193xsl.dgn	SHEET 68 OF 68