


LOCATE BENCH MARK AND BRIDGE PLAQUE

THE BENCH MARK AND BRIDGE PLAQUE WILL BE SUPPLIED BY THE AGENCY OF TRANSPORTATION AND SHALL BE INSTALLED BY THE CONTRACTOR AT ABUTMENT #1 ON THE RIGHT SIDE AS SHOWN OR AS DIRECTED BY THE ENGINEER.

TYPICAL BRIDGE SECTION

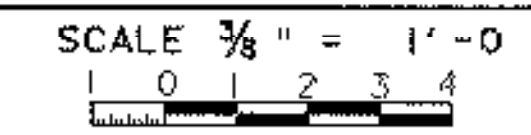

TYPICAL SECTION

STATE OF VERMONT AGENCY OF TRANSPORTATION	
Town Of DERBY	Bridge No. 64
Highway No. VT 105	Log. Sta. CLYDE RIVER
VT 105 OVER THE CLYDE RIVER	
TYPICAL BRIDGE SECTION	
Designed By M. EVANS-MONGEON	Drawn By M. EVANS-MONGEON
Checked By DATE	Bridge Design Supervisor C. KELLER Date DATE
PROJECT DERBY	PROJECT NO. BRF 034-3(14)
I.G.C. Info. /str 5.781199 /af 199sup.dgn	sf1501pp.f
Bridge Sheet No. 59	Sheet 59 of 127