

Bench Mark -1
 1+023.0m L-1
 Spike In Root
 Elev. 208.950

SIGN LEGEND
R&S = REMOVE AND SALVAGE


VTM CURVE 1
 Δ = 25°39'45.48"
 R = 170.000m
 T = 54.859m
 L = 104.926m
 C = 8.423m

SIGN POSTS
 SOLARIC STEEL
 50 mm x 3.9 x 19 mm
 W/ ANCHOR



STA 1+135 LT
 R&S

STA 1+193 LT
 R&S

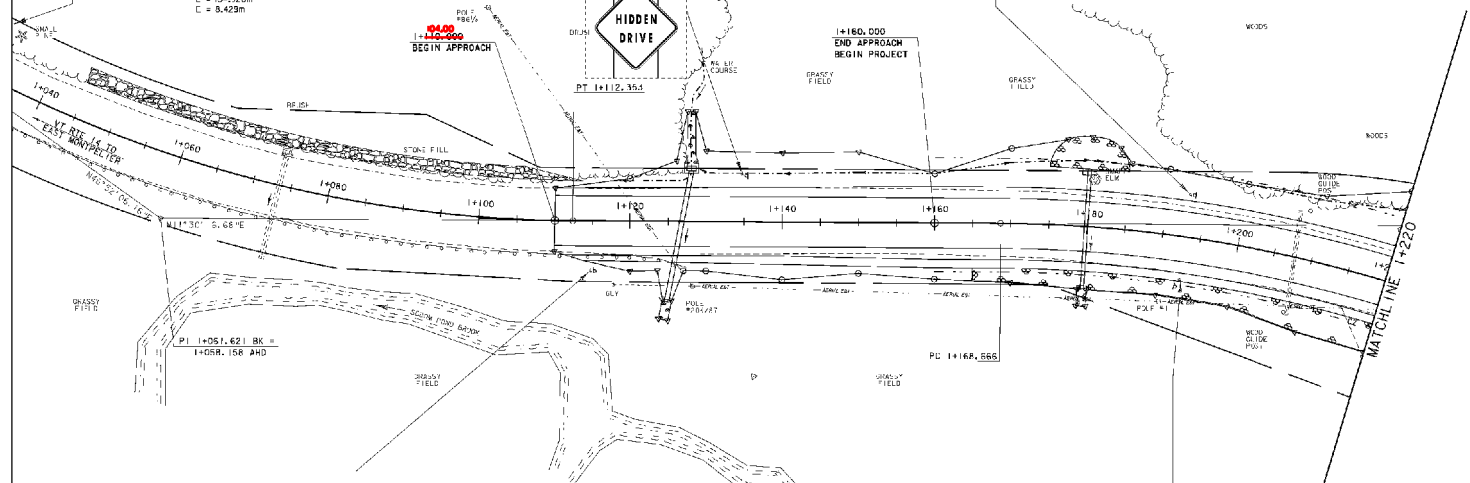

STA 1+115 RT
 R&S

REMOVAL OF EXISTING
 DE LINEATOR
 1+207.800 RT
 1+208.100 LT

REMOVAL & DISPOSAL
 OF GUARDRAIL
 1+1 4.800 - 1+127.710 RT

HD STEEL BEAM GUARDRAIL,
 GALVANIZED
 1+114.800 - 1+220.000 RT

COLD PLANNING BITUMINOUS PAVEMENT
 1+110.000 - 1+130.000

REMOVE SIGNS
 1+115 RT (2)
 1+135 LT (2)
 1+193 LT
 1+193 RT

ERECTING SALVAGED SIGNS
 1+115 RT (3)
 1+135 LT (2)
 1+192 LT
 1+193 RT

DURABLE 100 MM WHITE LINE, THERMOPLASTIC
 1+112.000 - 1+220.000 LT
 1+10.000 - 1+220.000 RT

DURABLE 100 MM YELLOW LINE, THERMOPLASTIC
 1+110.000 - 1+220.000 LT & RT



STA 1+192 RT
 R&S

LAYOUT SHEET #1

PROJECT NAME: EAST MONTPELER
 PROJECT NUMBER: STP 037-2(9)

FILE NAME: 28f200vstr\stf200bdr.dgn
 PROJECT LEADER: E. HIGGINS
 DRS CHECKED BY: J. LACROIX
 s2200LL
 PLOT DATE: 4-JUL-2009
 DRAWN BY: R. PELLET
 CHECKED BY: J. LACROIX
 SHW: II DR: BT

NOTE: THERE IS A SIGN PROJECT CURRENTLY UNDER CONSTRUCTION THAT MAY CHANGE THE TYPE/LOCATION OF SIGNS. EACH SIGN SHALL BE REMOVED, SALVAGED, AND ERECTED AS CLOSE TO ITS EXISTING LOCATION AS POSSIBLE.

