
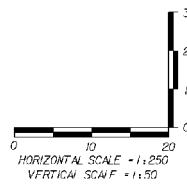


THE GRADES SHOWN TO THE NEAREST HUNDREDTH ARE THE ORIGINAL GROUND ELEVATIONS ALONG THE PROPOSED ALIGNMENT. THE GRADES SHOWN TO THE NEAREST THOUSANDTH ARE THE FINISH GRADES ALONG THE PROPOSED ALIGNMENT.

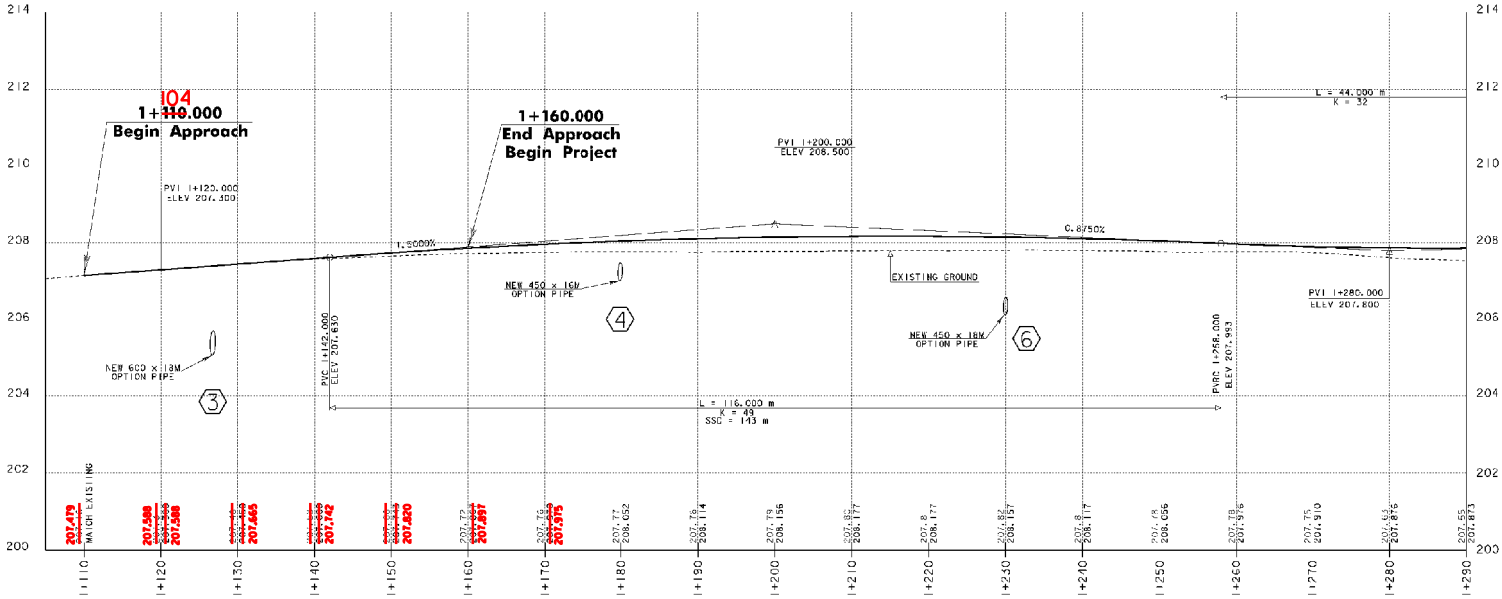

PROFILE SHEET #1

PROJECT NAME:	EAST MONTPELIER	FILE NAME:	78780200-1-167200ksa.dwg	PLOT DATE:	F-JUL-2009
PROJECT NUMBER:	STP 037-2(9)	PROJECT LEADER:	K. HIGURS	DRAWN BY:	K. MULLILLI
		DESIGNED BY:	J. LARROK	CHECKED BY:	J. LARROK
			st200cplli	SHEET	14 OF 67