
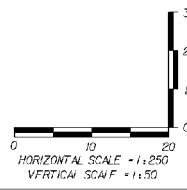


THE GRADES SHOWN TO THE NEAREST HUNDRETH ARE THE ORIGINAL GROUND ELEVATIONS ALONG THE PROPOSED ALIGNMENT. THE GRADES SHOWN TO THE NEAREST THOUSANDTH ARE THE FINISH GRADES ALONG THE PROPOSED ALIGNMENT.

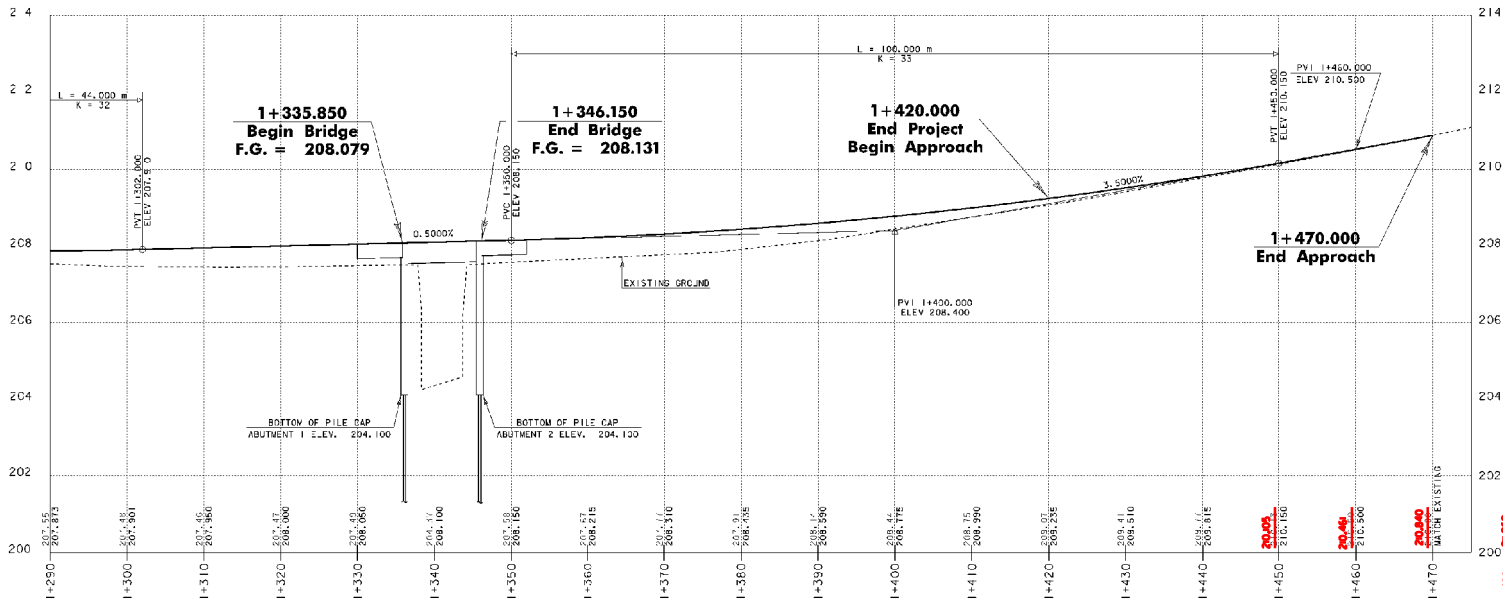

PROFILE SHEET #2

PROJECT NAME:	EAST MONTEPELIER	PLLOT DATE:	16-JUL-2009
PROJECT NUMBER:	STP 037-2(9)	DRAWN BY:	M. PELLETTI
FILE NAME:	787200.dwg	CHECKED BY:	J. LACROIX
PROJECT LEADER:	K. HIGBES	SHEET	15 OF 67
DESIGNED BY:	J. LACROIX		