

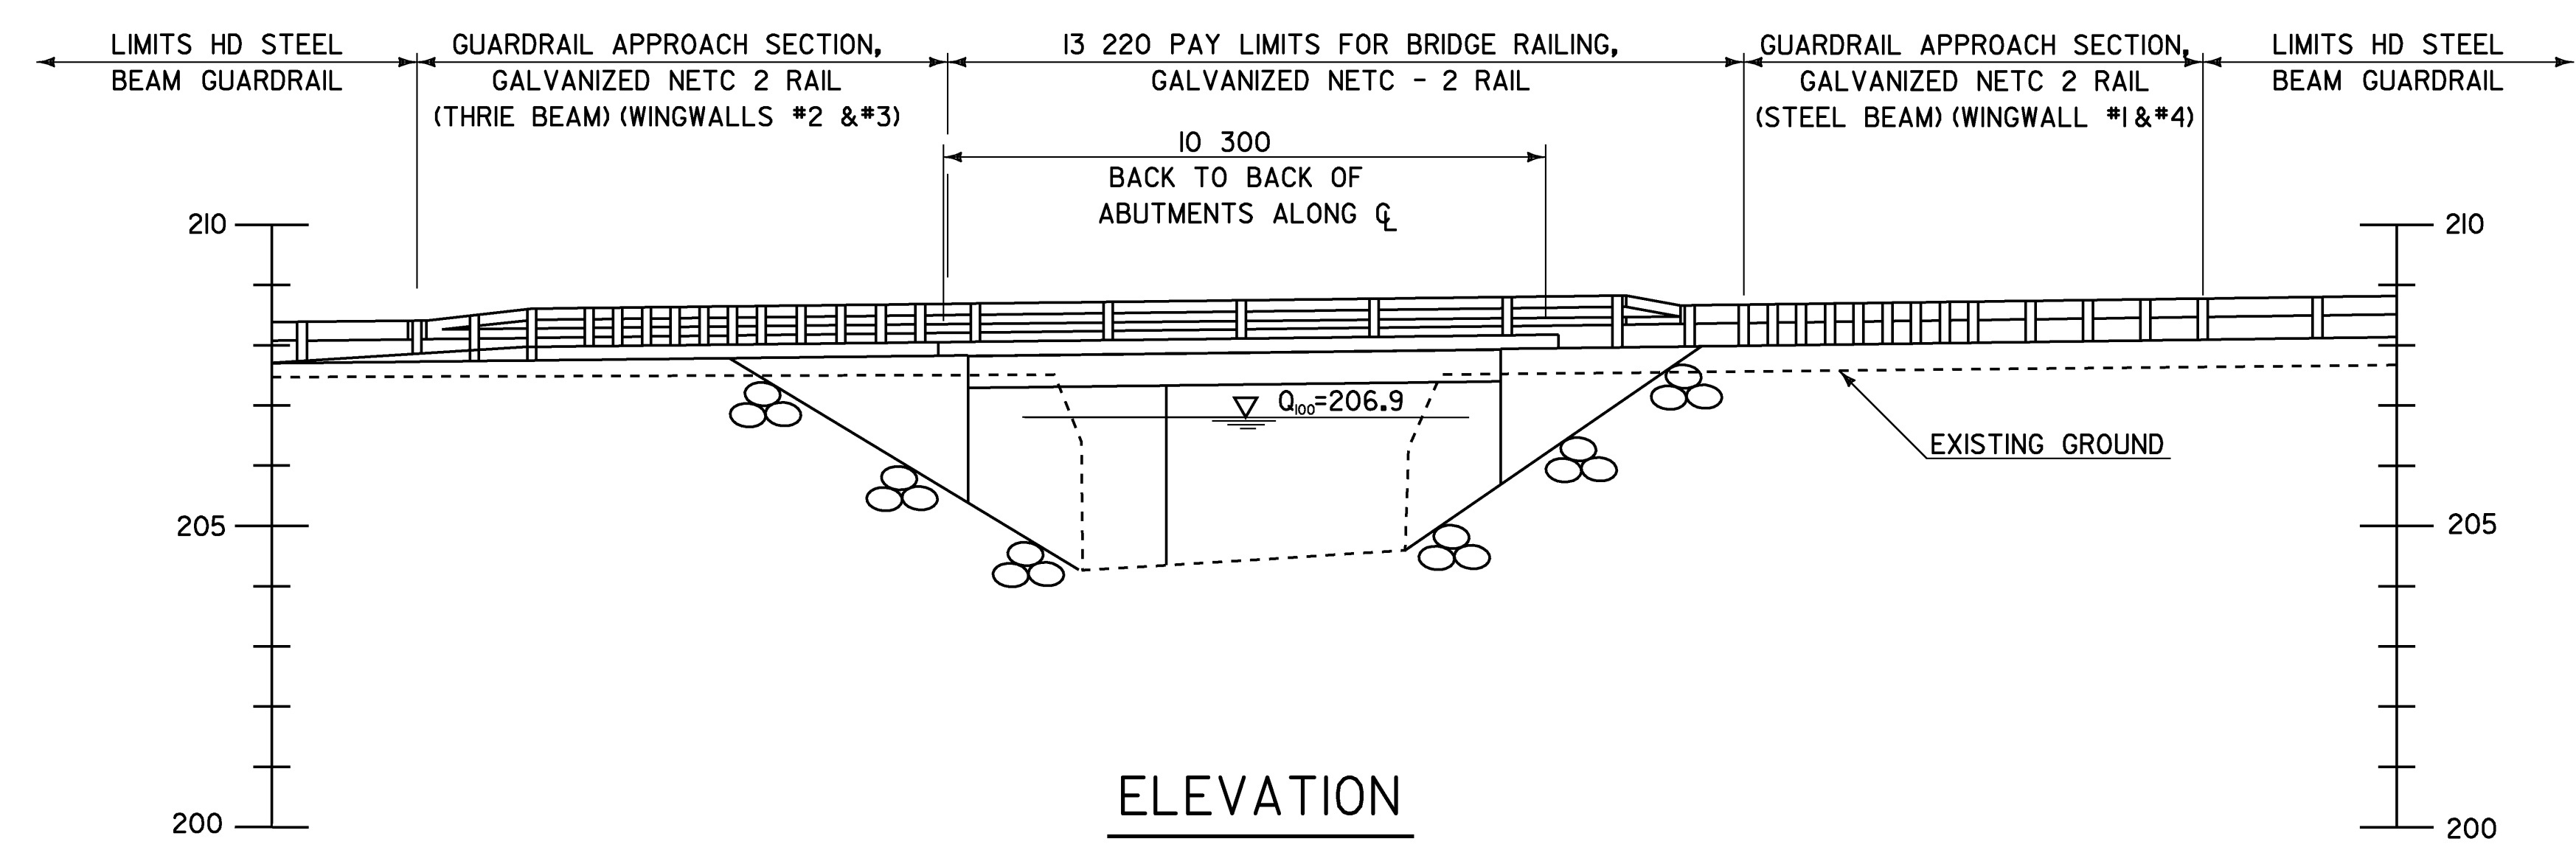


PLAN

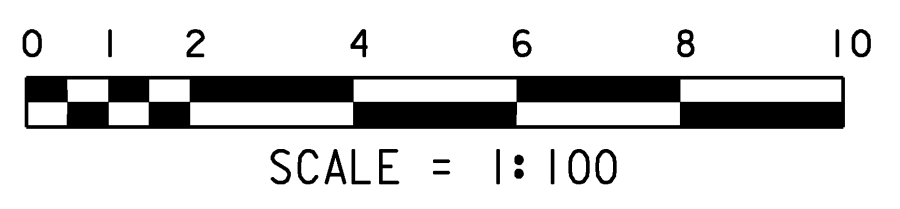

ELEVATION

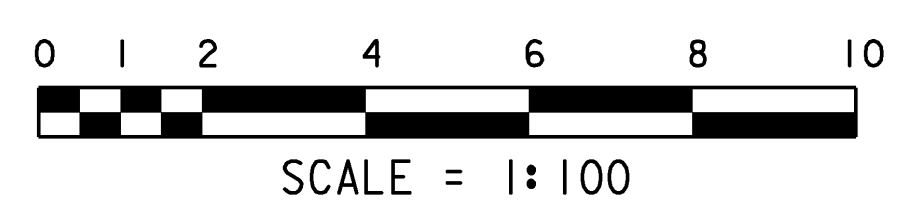

SEE BRIDGE RAILING LAYOUT & DETAIL SHEETS FOR COMPLETE BRIDGE & APPROACH RAIL DETAILS

PLAN & ELEVATION

PROJECT NAME: EAST MONTPELIER	PLOT DATE: 14-JUL-2009
PROJECT NUMBER: STP 037-2(9)	DRAWN BY: R. PELLETT
FILE NAME: 78f200\str\s200pe.dgn	CHECKED BY: J. LACROIX
PROJECT LEADER: K. HIGGINS	SHEET 31 OF 67
DESIGNED BY: J. LACROIX	
sf200pe.1	