



ABUTMENT #2 PLAN
SCALE = 1:40

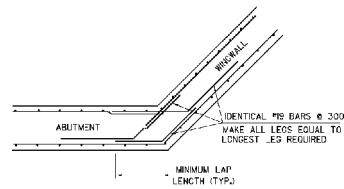


WINDWALL CORNER DETAIL

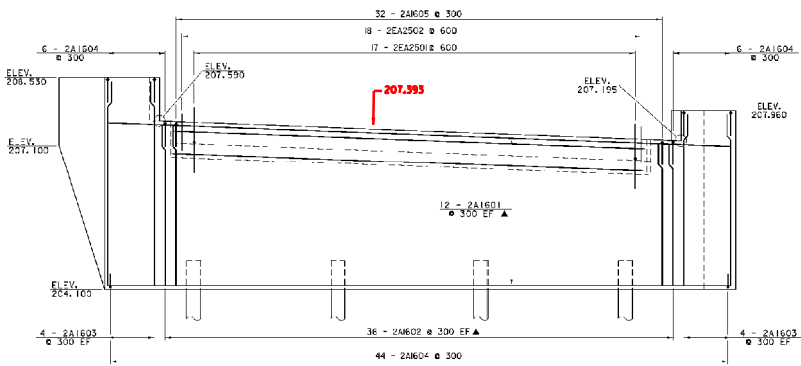

ABUTMENT #2 REINFORCING ELEVATION
SCALE = 1:40

NOTE:
SEE APPROACH SLAB DETAILS SHEET
FOR A.C.L.E. DETAIL

NOTE:
NF = NEAR FACE
FF = FAR FACE
EF = EACH FACE
▲ = CURT TO PILE FIELD
RO CIFAR, IIM FSS OTHERWISE
SPECIFIED ON THE PLANS.
600 BAR LAP UNLESS OTHERWISE
SPECIFIED ON THE PLANS.

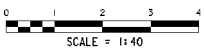

ABUTMENT #2 DETAILS

PROJECT NAME:	EAST MONTPELIER	PLLOT DATE:	F-JUL-2009
PROJECT NUMBER:	STP 037-2(G)	DRAWN BY:	M. PULLI
FILE NAME:	787200.dwg	CHECKED BY:	G. BRODIE
PROJECT LEADER:	K. HIGGS	SHEET	36 OF 67
DESIGNED BY:	J. LARSON		