

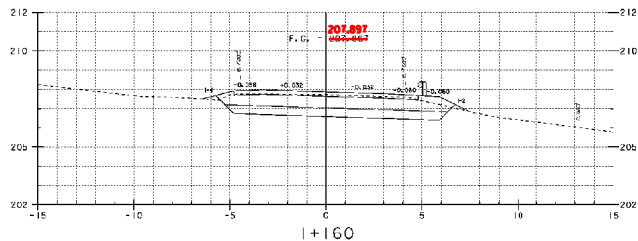
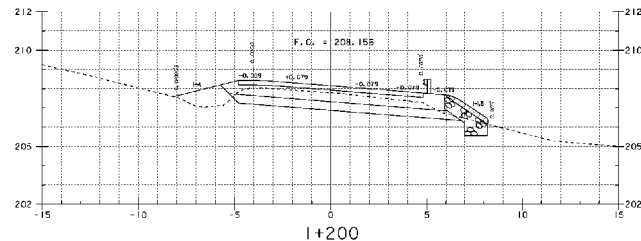
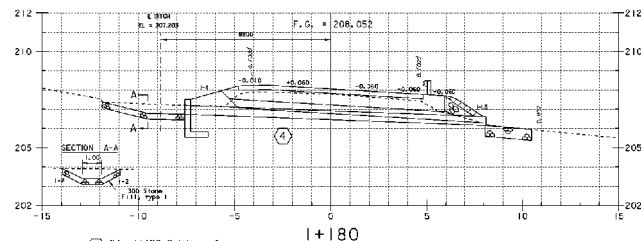


H 465, RT BEGON STONE FILL, TYPE #

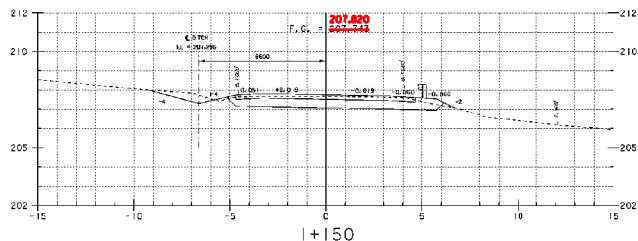

End Approach
Begin Project

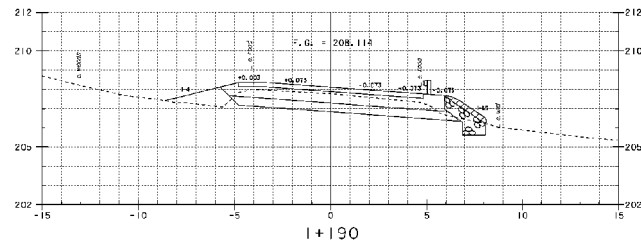

④ Site I+180.0 L.T. - 4'-
New 460 x 16M Option Pipe w/ New concrete headwall @ Inlet
New Inlet and Outlet ditches w/stone fill, Type I

STA 1+150 - STA 1+200

MAINLINE CROSS SECTIONS #2

PROJECT NAME:	EAST MONTPELIER	PLLOT DATE:	8-JUL-2009
PROJECT NUMBER:	STP 037-2(9)	DRAWN BY:	M. LITTLE
FILE NAME:	787200.dwg	CHECKED BY:	J. LACROIX
PROJECT LEADER:	J. LACROIX	SHEET	59 OF 67
DESIGNED BY:	J. LACROIX		

