

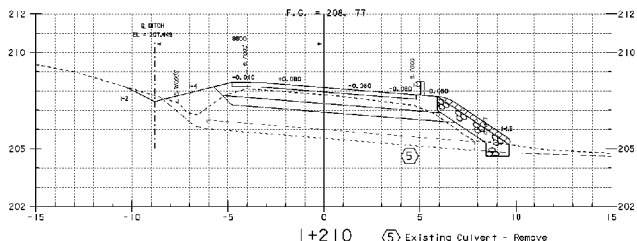
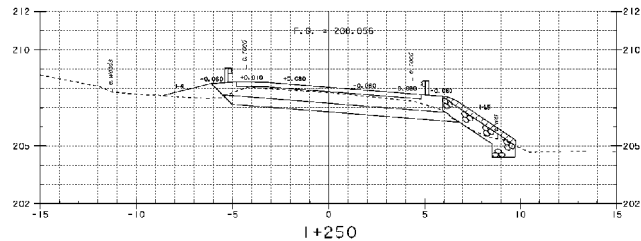
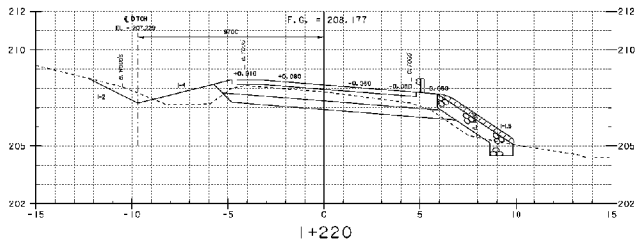


⑤ Sta 1+230.0 Lt. - Rt.
New 450 x 8M Option Pipe w/ New concrete headwall • Inlet
New Inlet and Outlet ditches w/ Stone Fill, Type I

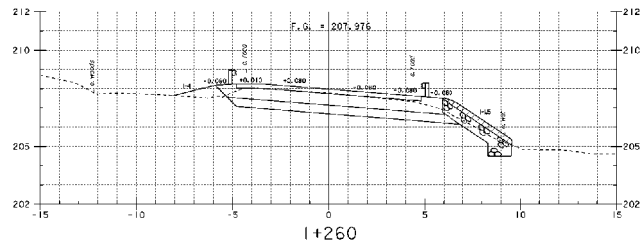

⑤ Existing Culvert - Remove

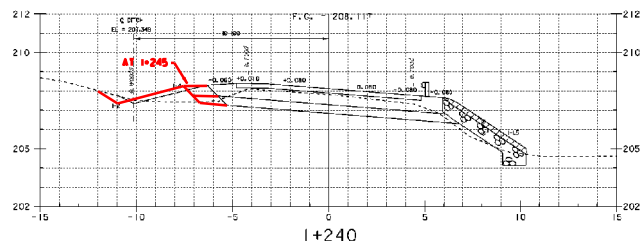

**STA 1+210 - STA 1+260
MAINLINE CROSS SECTIONS #3**

PROJECT NAME:	EAST MONTPELIER	PLLOT DATE:	8-JUL-2009
PROJECT NUMBER:	STP 037-2(3)	DRAWN BY:	M. LITTLE
FILE NAME:	STP037-2(3)-1+210x8M.dwg	DESIGNED BY:	J. LACROIX
PROJECT LEADER:	K. HIGGINS	CHECKED BY:	J. LACROIX
SCALE:	1"=100'	SHEET:	60 OF 67

