

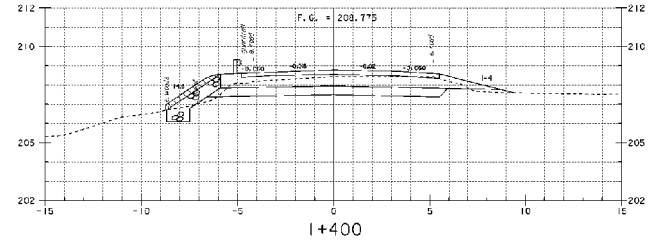
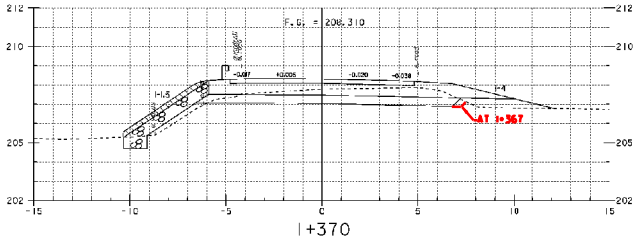
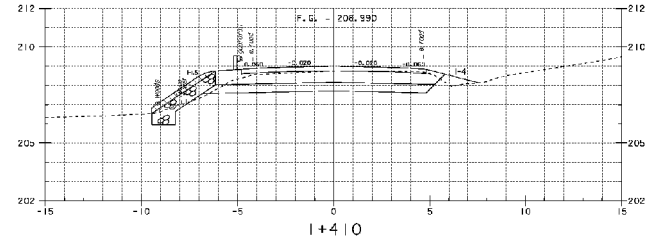
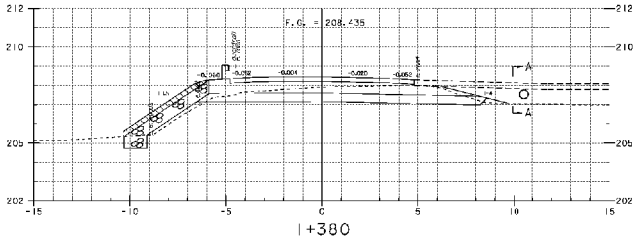
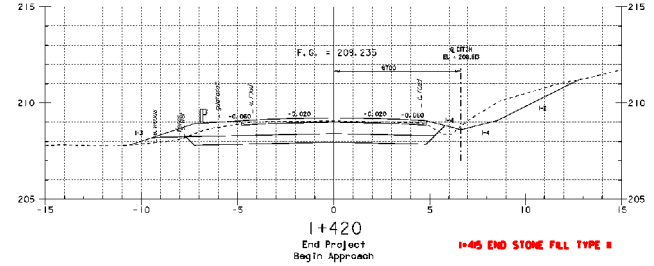


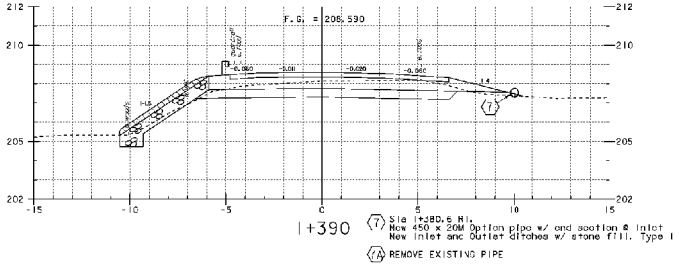

Section A-A

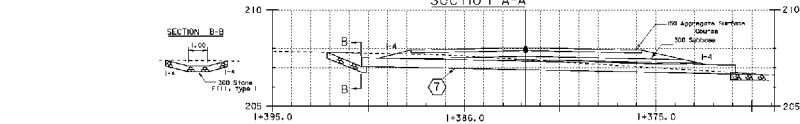

STA 1+370 - STA 1+420
MAINLINE CROSS SECTIONS #7

PROJECT NAME:	EAST MONTPELIER	PLLOT DATE:	8-JUL-2009
PROJECT NUMBER:	STP 037-2(9)	DRAWN BY:	M. LITTLE
FILE NAME:	787200.dwg	DESIGNED BY:	J. LACROIX
PROJECT LEADER:	J. LACROIX	CHECKED BY:	J. LACROIX
SCALE:	1" = 100'	SHEET:	64 OF 67

