




I+450

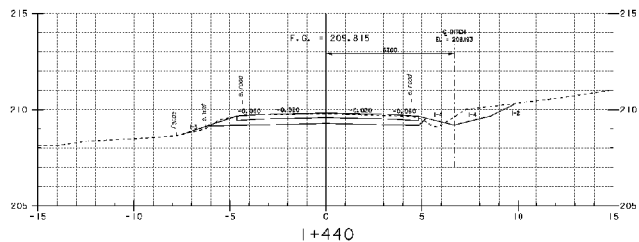

I+440

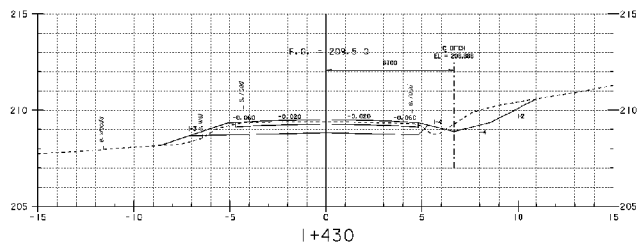


I+430

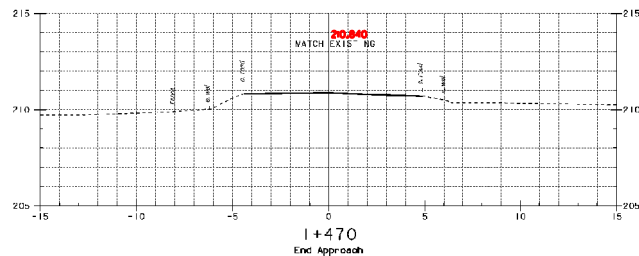

I+470

End Approach

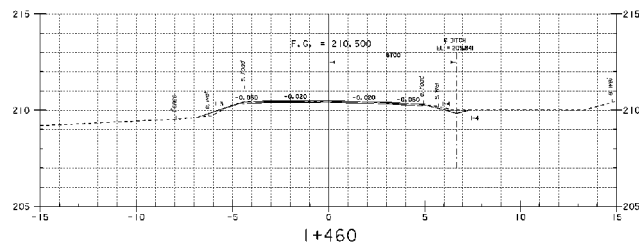

I+460

**STA 1+430 - STA 1+470
MAINLINE CROSS SECTIONS #8**

PROJECT NAME:	EAST MONTPELIER	PLLOT DATE:	F-JUL-2009
PROJECT NUMBER:	STP 037-2(9)	DRAWN BY:	M. LITTLE
FILE NAME:	787200.dwg	DESIGNED BY:	J. LACROIX
PROJECT LEADER:	K. HIGGINS	CHECKED BY:	J. LACROIX
SCALE:	1"=200'	SHEET:	65 OF 67

