


ALIGNMENT & TIE SHEET

1. Traverse Line, May 1979
2. Survey Line, Feb 1981
3. Revised Line, Dec 1983

Note: Survey Line, May 1979 is not shown.

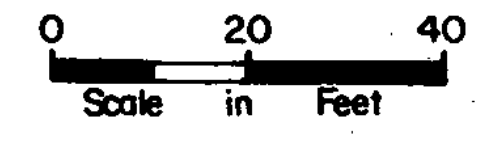

SURVEYED BY	Fall	DATE	2-81
DRAWN BY	Toolan	DATE	11-83
TRACED BY	Toolan	DATE	11-83
FAIRFAX			
PROJ. BRS	NO. 0229(2)5		
SHEET	2	of 98	