


DATUM

VERTICAL	Assumed
HORIZONTAL	N/A

SURVEYED BY	Fall	DATE	2-81
DRAWN BY	Hodge & Lohr	DATE	3-81
TRACED BY	Toolan	DATE	11-83
FAIRFAX			
PROJ. BRS	NO. 0229(2) S		
SHEET 15 OF 98			

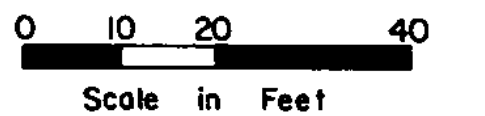

12-1-83 EJT