


Temporary 4" Reflectorized White Line
 20+00 ~ 26+00 11' Lt
 20+00 ~ 26+00 11' Rt

Temporary 4" Reflectorized Yellow Line
 20+00 ~ 25+71 Lt (solid)
 25+71 ~ 26+00 Lt (dashed)
 20+00 ~ 26+00 Rt (dashed)

Guard Rail, Standard Steel Beam w/ Wood Posts, Type II
 22+87.5 Lt ~ 23+37.5 Lt
 22+90.5 Rt ~ 23+28 Rt
 25+14 Lt ~ 25+89 Lt
 25+04.5 Rt ~ 25+79.5 Rt

DATUM	VERTICAL	Assumed
	HORIZONTAL	N/A

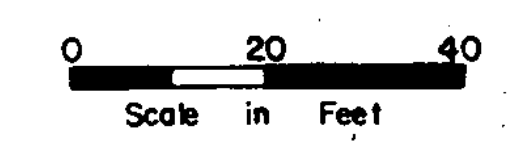

SURVEYED BY	Fall	DATE	2-81
DRAWN BY	H. Lohr	DATE	3-81
TRACED BY	Todan	DATE	11-83
FAIRFAX			
PROJ. BRS	NO.	0229(2) S	
SHEET		16 OF 98	