



SURVEYED
 PLOTTED
 ALIGNMENT CHECKED
 NOTE BOOK
 REF. OF WAY CHECKED
 NO.

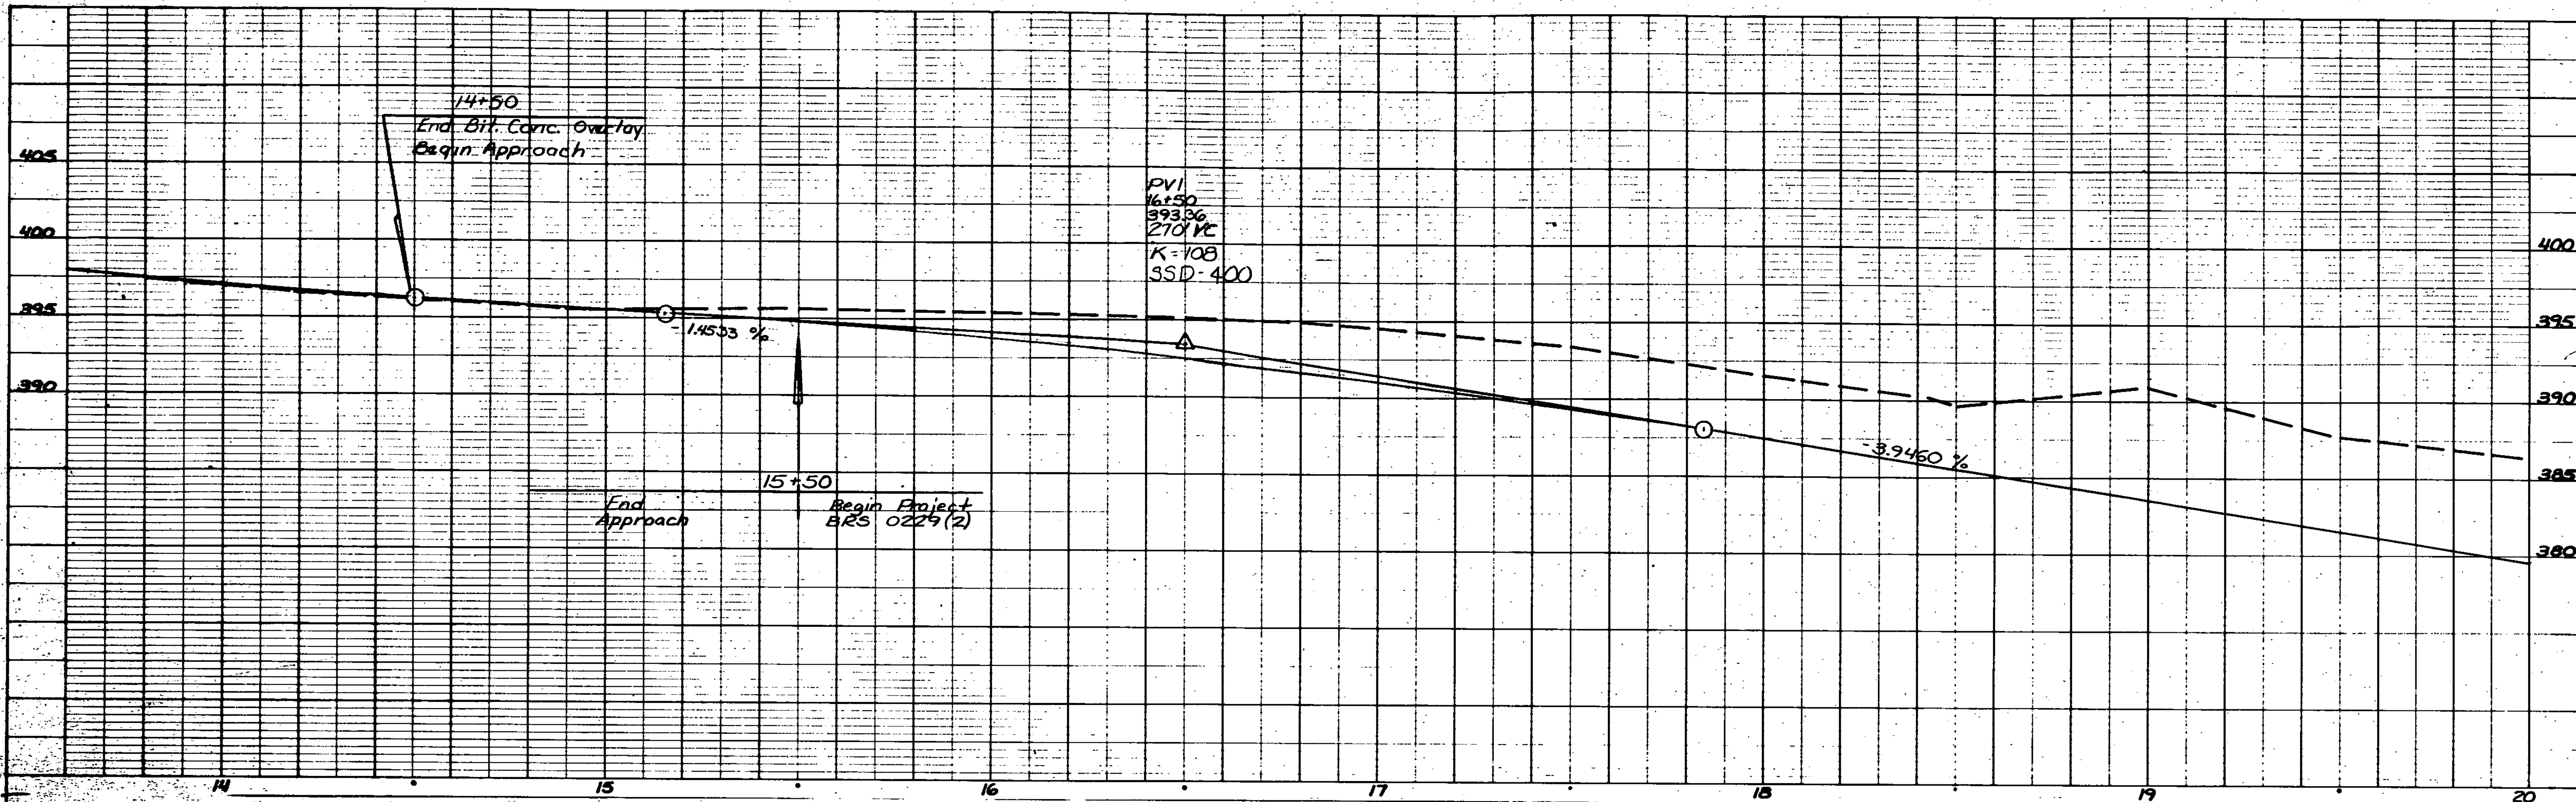

SURVEYED
 PLOTTED
 GRADES CHECKED
 NOTE BOOK
 STRUCTURE NOTATION CHECKED
 NO.

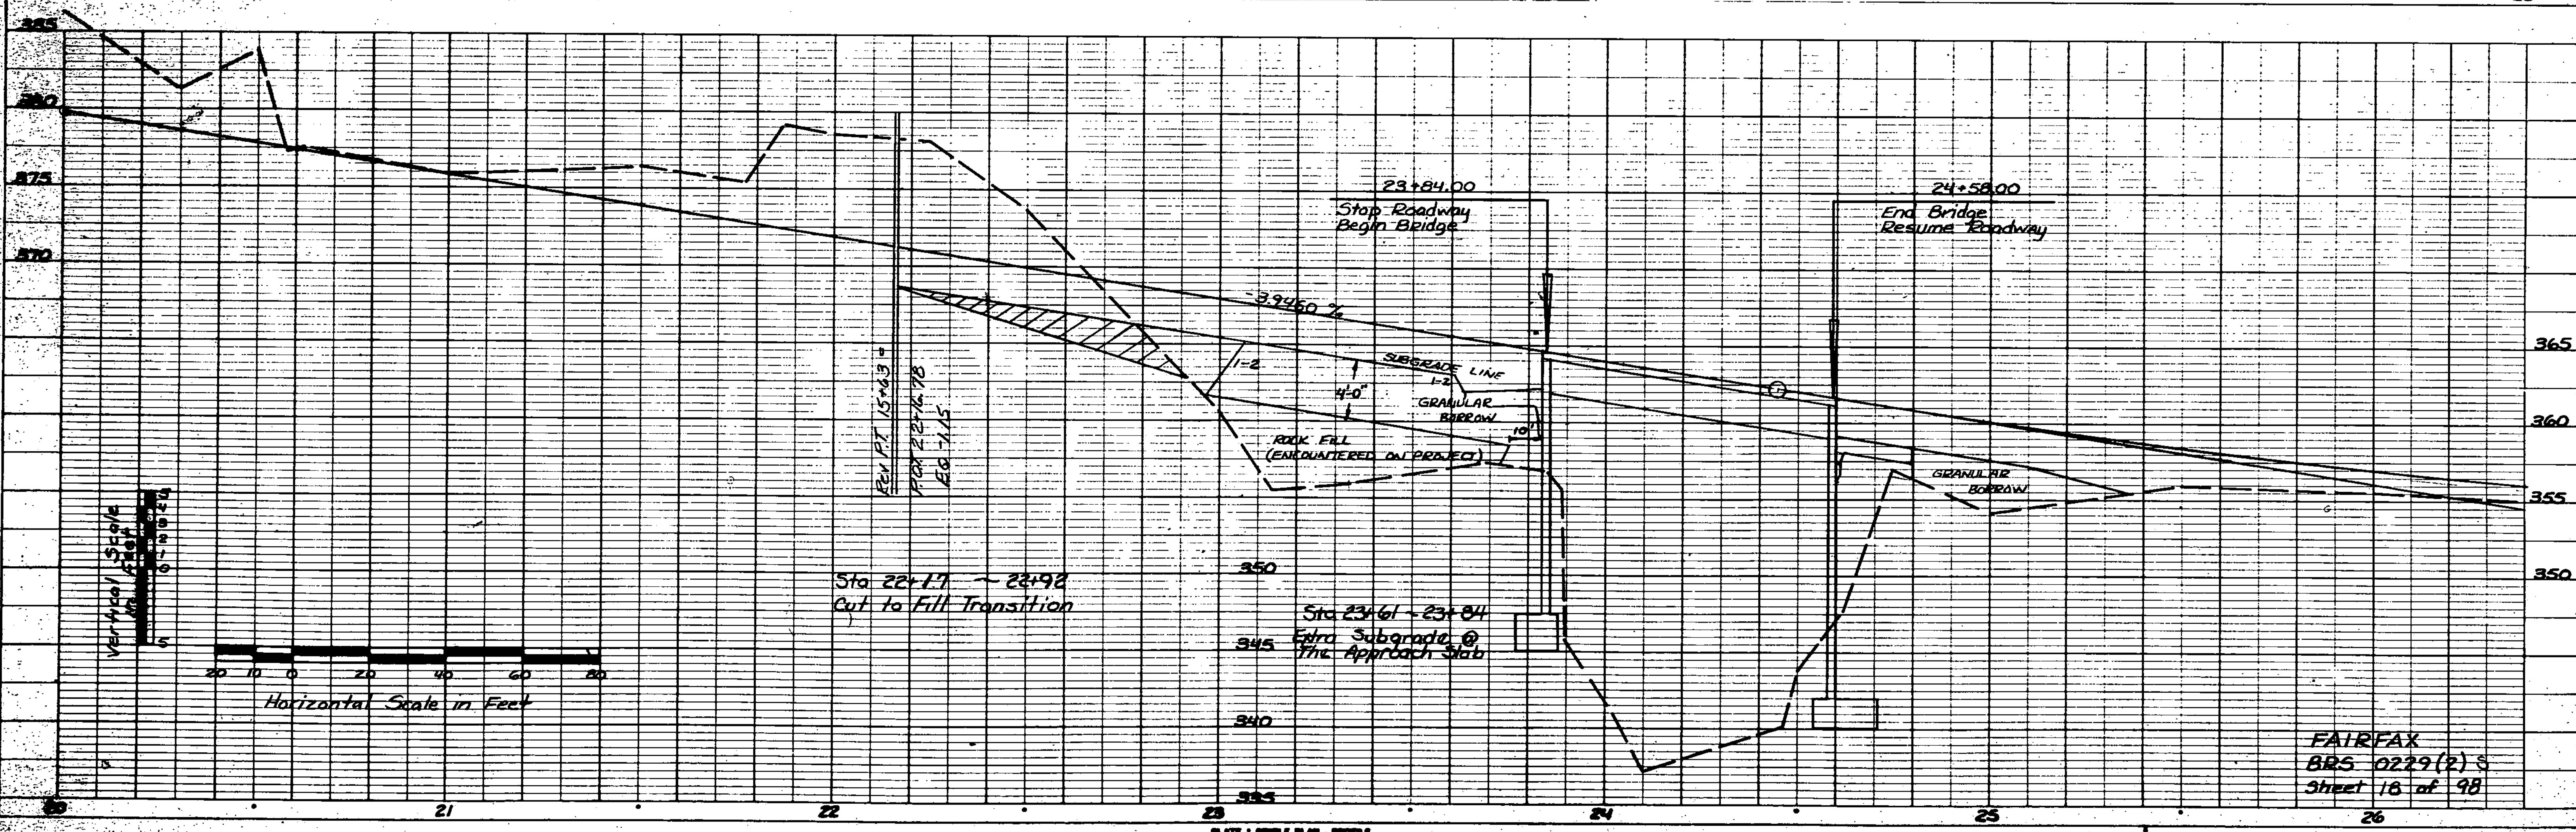

FAIRFAX
 BRS 0229(2) S
 Sheet 16 of 98