


PLAN  
 DESIGNED  
 PLOTTED  
 GRADES CHECKED  
 ALIGNMENT CHECKED  
 NOTE BOOK  
 RT. OF WAY CHECKED  
 NO.

PROFILE  
 DESIGNED  
 PLOTTED  
 GRADES CHECKED  
 STRUCTURE NOTATION CHECKED  
 NOTE BOOK  
 NO.

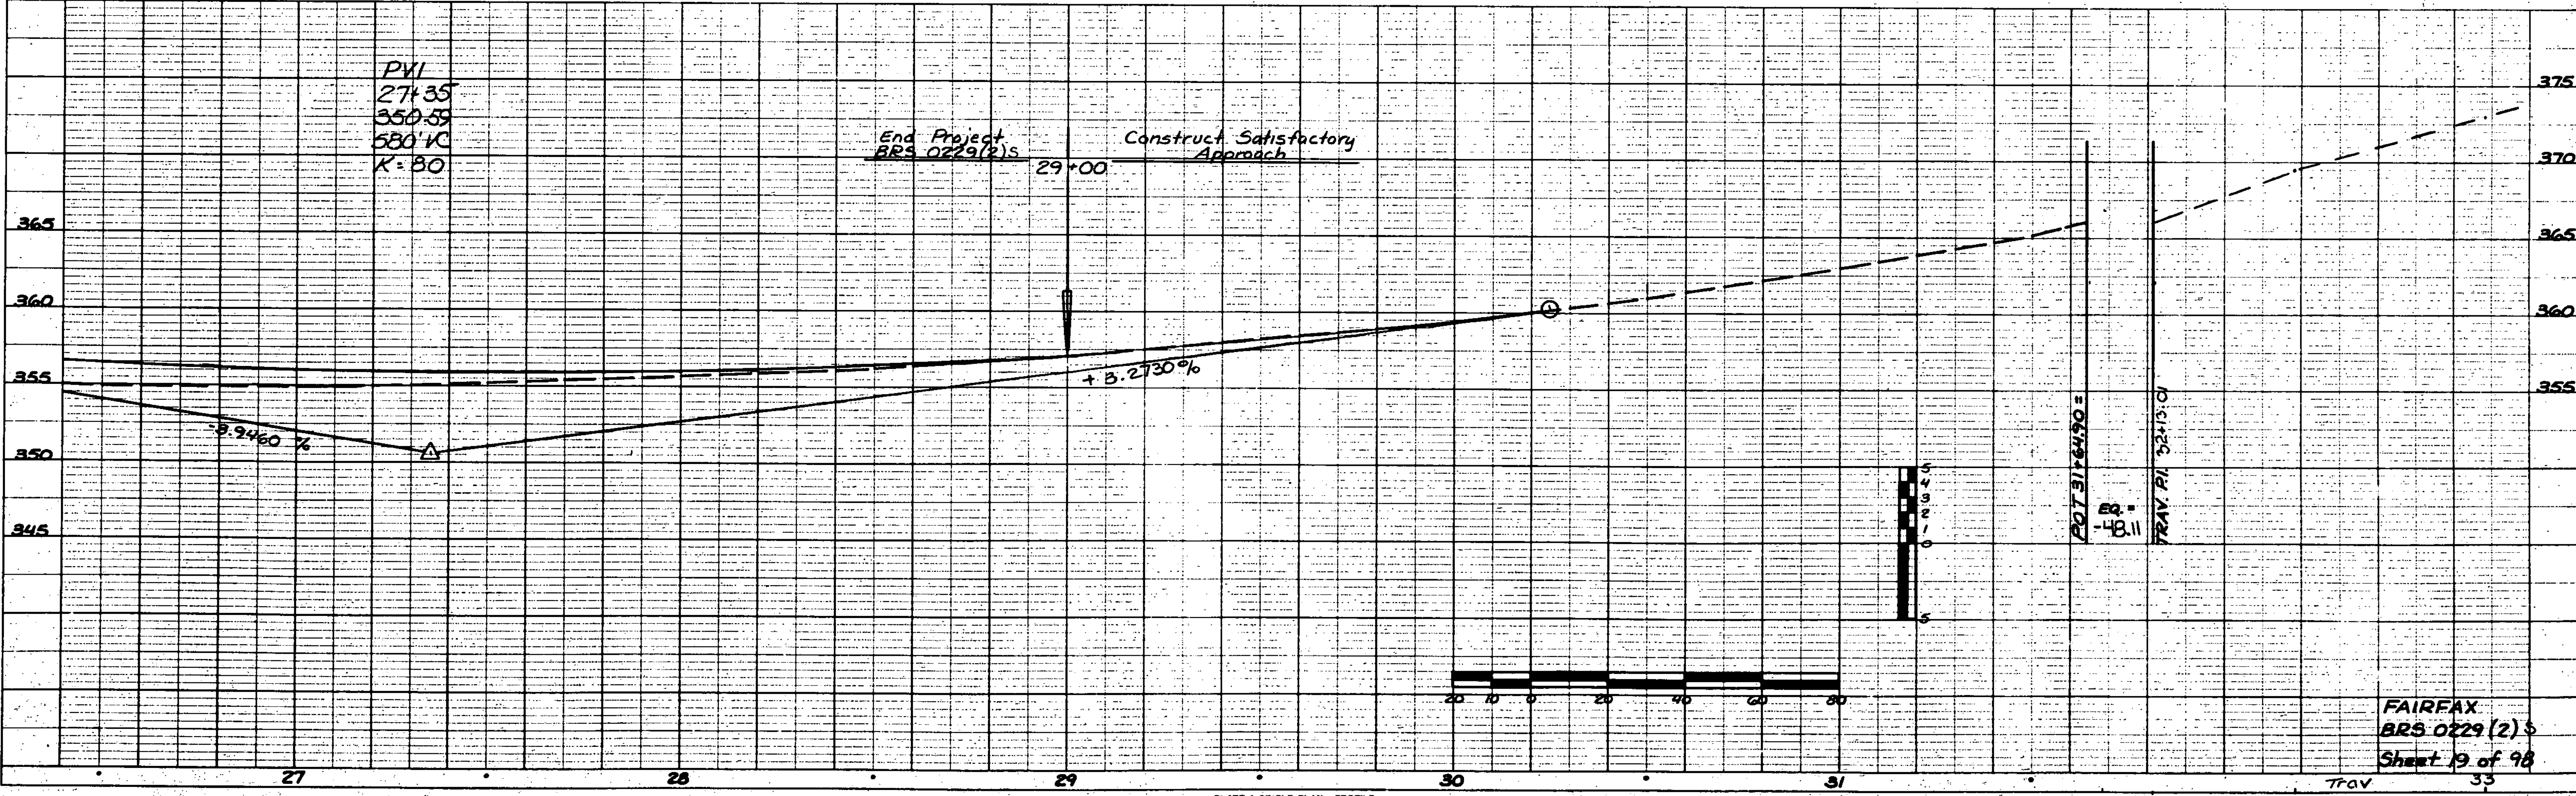

BRUNING 44-131 53428

FAIRFAX  
 BRS 0229 (2) S  
 Sheet 19 of 98