


BORING NOMENCLATURE

- ⊕ STANDARD PENETRATION BORINGS
 SAMPLER OUTSIDE DIAMETER 2"
 SAMPLER INSIDE DIAMETER 1 3/8"
 WEIGHT OF HAMMER 140 LBS
 HAMMER FALL 30"
- ⊕ AUGER BORINGS
- ⊙ ROD SOUNDINGS
- UP UNDISTURBED PISTON SAMPLE
- VS FIELD VANE SHEAR SAMPLE

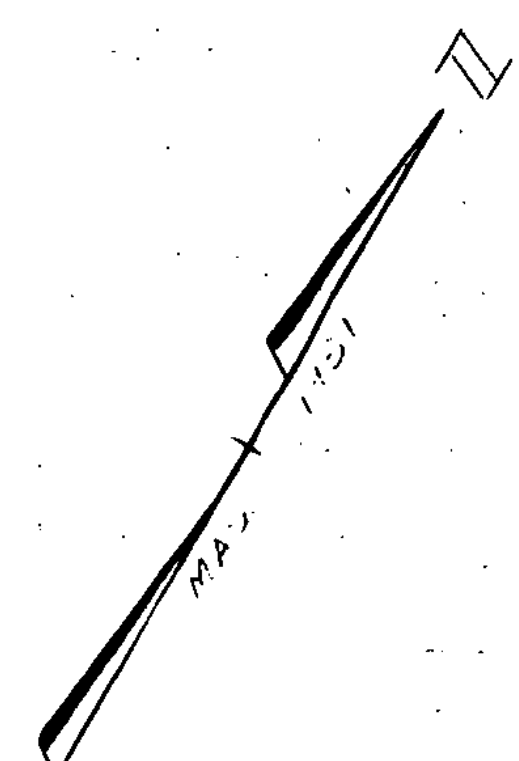

M. 17 20+82.00
 20+71.43
 Δ 10 16 RT
 D 12' 00"

Tran. PT. 22+11.00
 Δ 39° 53' 30" RT

CORR FIELD
 BM #4
 CH. 4 ON TOP CORNER
 BENCH MARKING
 ELEV. 371.81

REV. 2 CURVE #3
 Δ 19° 13' 40" LT.
 D 7' 30"
 R 763.944
 T 129.36
 L 256.30
 E 10.85

REV. 2 POST. 26+11.43
 Tran. PT. 26+59.36
 Δ 30° 49' 30" RT

REV. 2 PT. 26+04.17 EL.
 = 26+01.75

BORING LAYOUT

SCALE: 1"=20'

SURVEYED BY FALLS DATE 2-91
 DRAWN BY HODGE & LOHR DATE 3-24-91
 TRACED BY CELOHR DATE 3-25-91
 FAIRFAX
 PROJ. BR. NO. 0224(2)5
 SHEET 24 OF 98 BR803

BORING	REV2 STA.	OFFSET
B1	23+83	17 LT.
B2	23+77	5 LT.
B3	23+50	17 RT.
B4	22+60	15 RT.
B5	24+79	22 RT.
B6	24+54	17 RT.
B7	24+59	2
B8	24+64	17 LT.
B-1B	23+16	10 RT.
B-2B	23+46	17 RT.

- GENERAL NOTES**
- THE SUBSURFACE EXPLORATIONS SHOWN HEREON WERE MADE BETWEEN 2-10-82 AND 3-16-83 BY THE VERMONT AGENCY OF TRANSPORTATION.
 - SOIL AND ROCK (WHERE ENCOUNTERED) CLASSIFICATION, PROPERTIES AND DESCRIPTIONS ARE BASED ON ENGINEERING INTERPRETATION OF AVAILABLE SUBSURFACE INFORMATION BY THE VERMONT AGENCY OF TRANSPORTATION AND MAY NOT NECESSARILY REFLECT ACTUAL VARIATIONS IN SUBSURFACE CONDITIONS THAT MAY BE ENCOUNTERED BETWEEN INDIVIDUAL BORING OR SAMPLE LOCATIONS.
 - OBSERVED WATER LEVELS AND/OR WATER CONDITIONS INDICATED ARE AS RECORDED AT THE TIME OF EXPLORATION AND MAY VARY ACCORDING TO THE PREVAILING RAINFALL, METHODS OF EXPLORATION AND OTHER FACTORS.
 - SOIL ENGINEERING JUDGEMENT WAS EXERCISED IN PREPARING THE SUBSURFACE INFORMATION PRESENTED HEREON. ANALYSIS AND INTERPRETATION OF SUBSURFACE DATA WAS PERFORMED AND INTENDED FOR AGENCY DESIGN AND ESTIMATE PURPOSES ONLY. PRESENTATION OF THE INFORMATION ON THE PLANS OR ELSEWHERE IS FOR THE PURPOSE OF PROVIDING INTENDED USERS WITH ACCESS TO THE SAME DATA AVAILABLE TO THE AGENCY. THE SUBSURFACE INFORMATION IS PRESENTED IN GOOD FAITH AND IS NOT INTENDED AS A SUBSTITUTE FOR PERSONAL INVESTIGATION, INDEPENDENT INTERPRETATIONS, INDEPENDENT ANALYSIS OR JUDGEMENT OF THE CONTRACTOR.
 - PICTORIAL STRUCTURE DETAILS SHOWN HEREON ARE FOR ILLUSTRATIVE PURPOSES ONLY AND MAY NOT BE INDICATIVE OF THE FINAL DESIGN CONDITIONS SHOWN IN THE CONTRACT PLANS.

DATUM
 VERTICAL ASSUMED
 HORIZONTAL N/A

BORING 44-31-4282