



13+75 Lt.  
 6' Underdrain - Retain  
 Rev. P.C. 13+94.16  
 D - 2' 00" Lt.  
 Full Banking .030 Off

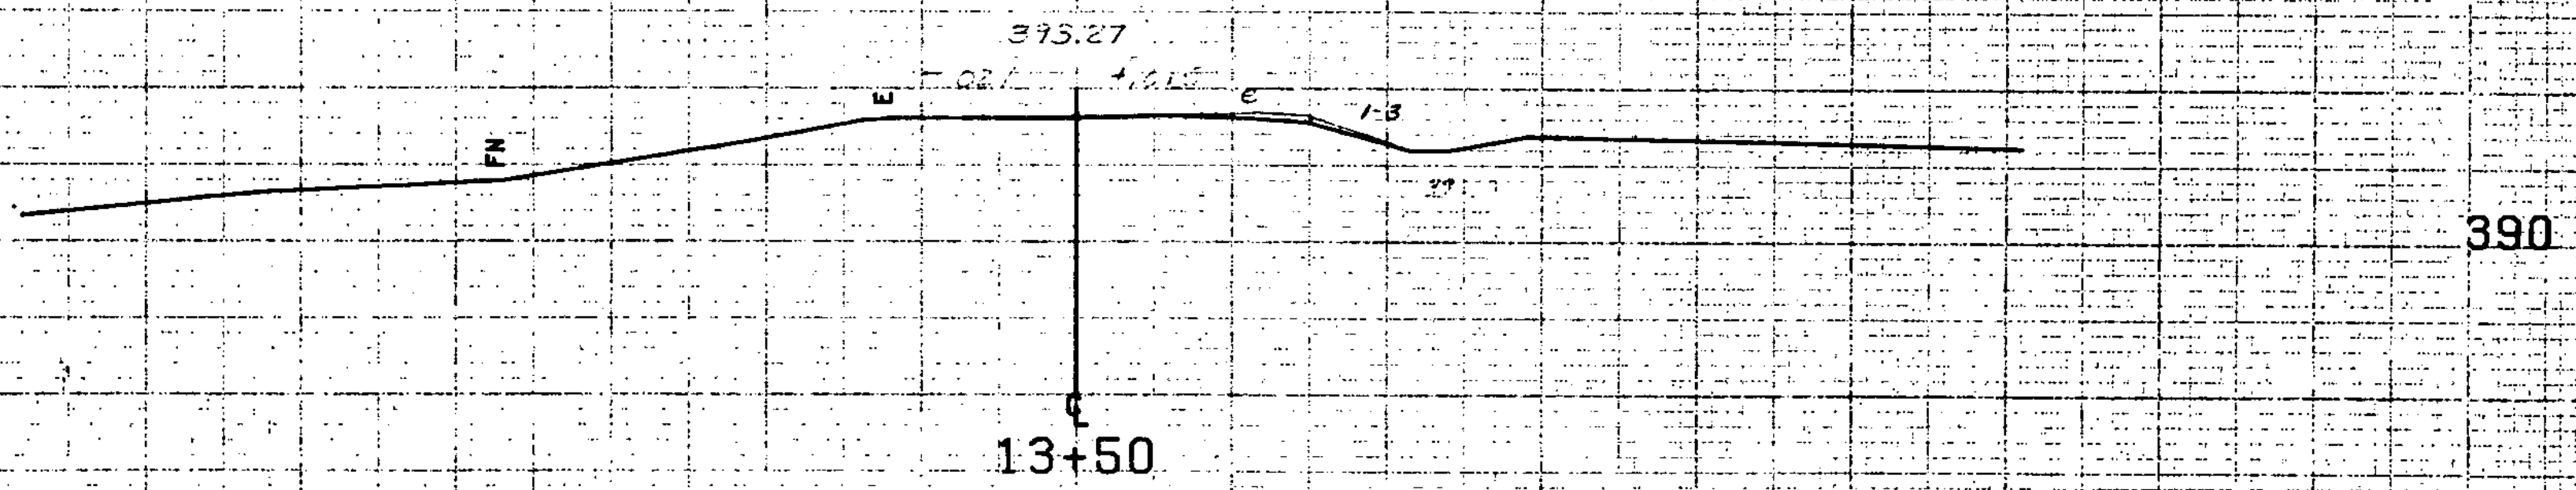

1015  
 X 2  
 2'

+ ON D  
 X 2  
 NLT  
 EA

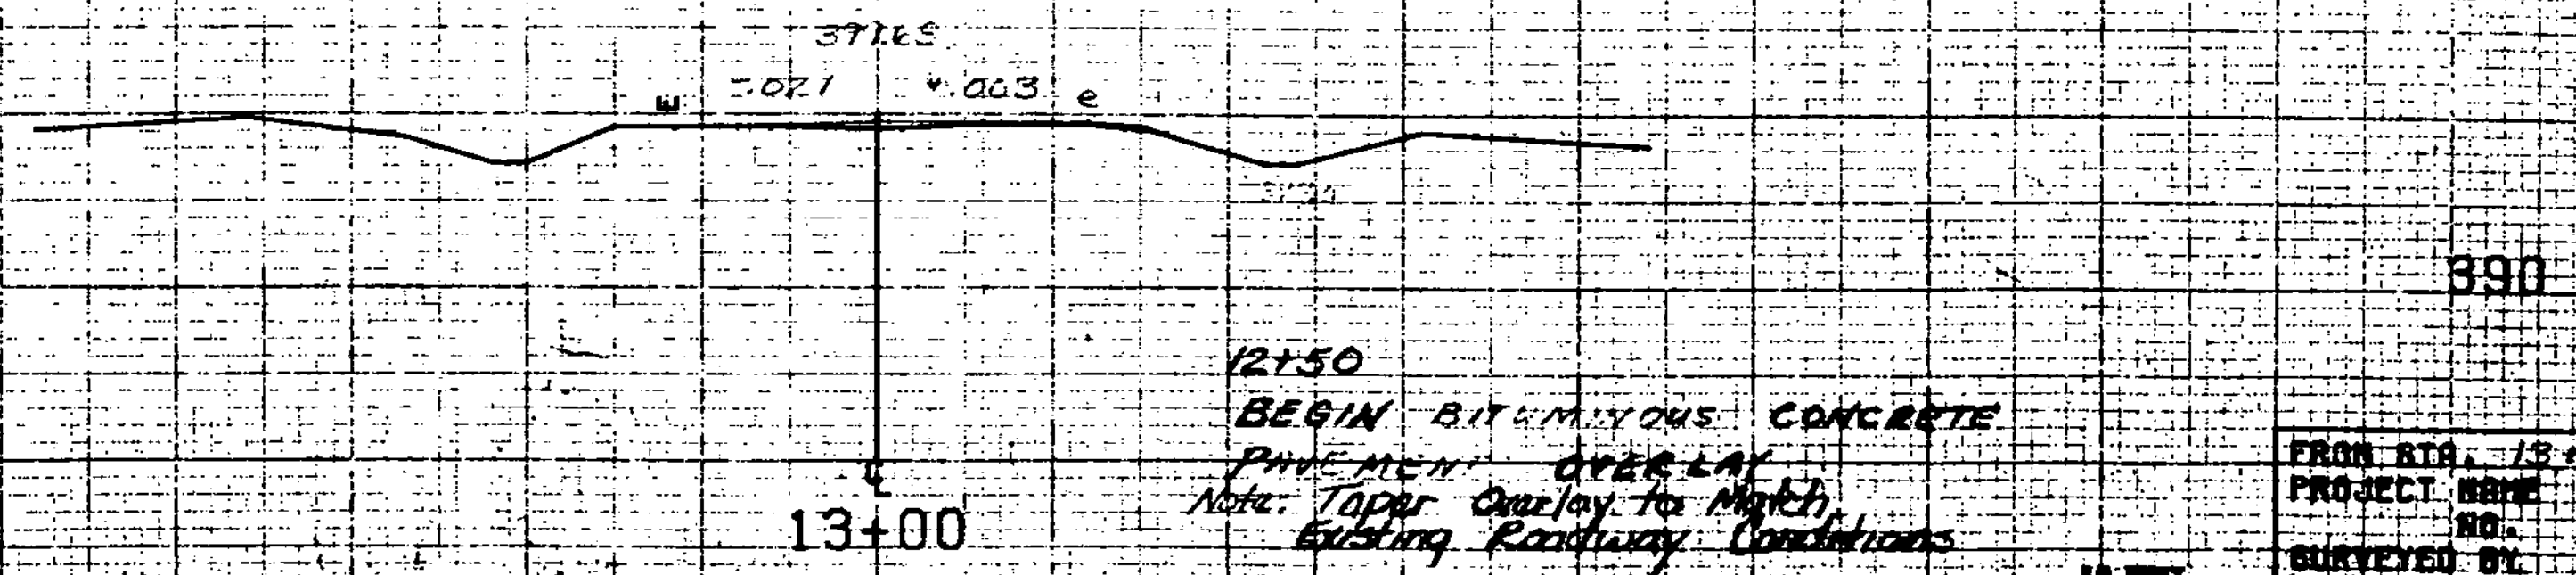

12+50  
 BEGIN BITUMINOUS CONCRETE  
 PAVE WITH OVERLAY  
 Note: Taper Overlay to Match  
 Existing Roadway Conditions

FROM STA. 13+00	TO STA. 14+00
PROJECT NAME	PROJECT NAME
NO.	NO.
SURVEYED BY	PLOTTED BY
DATE	DATE